

Name Frederick A. Connor

1365  
Service No. 85 2282

Address 35 Prospect Hill Rd. Marrett Road

Locatio Lot #6, Prospect Hill Rd.

#35  
(66)

Kind of Pipe Size Size of Main

~~Repair - Renewal~~ - New Service Location

Date	Material	Amount	Total	Date	Amount
P. 12-22-31 for 35-25	47' 1" Copper Pipe @.26	12 22			
	1 1" C. to I. Ell	35			
	1 S & W	3 00			
	Trucking	75	16 32		
				Dec. 2 1931 - Cash	31 50
				A.R. 2-24-32	
				2-25-32	
				April 18 1932 - Cash	3 75
11/6/31	7 Hrs. Labor @ .55	3 85			
	3 " " @ .60	1 80	5 65		
	15% Overhead		85		
	<u>Cost</u>		22 82		
CHARGE	47' @ .75	\$35 25	\$35 25		
	Labor				

Clay Press, Inc., Lexington

DATE Dec 2-01

TOWN OF LEXINGTON—BOARD OF PUBLIC WORKS

WATER DIVISION *L.D. #6*

The undersigned applies for a supply of water at No. #35 Prospect Hill Rd St. and hereby agrees to comply with the rules and regulations as now, or at any future time, established by the Board of Selectmen.

Am't. of Estimate \$ 31.50

Owner

Frederic A. Souther  
R.


Am't. Paid \$ None

Address

\_\_\_\_\_

Builder \_\_\_\_\_

22  
70  
210  
240  
3180

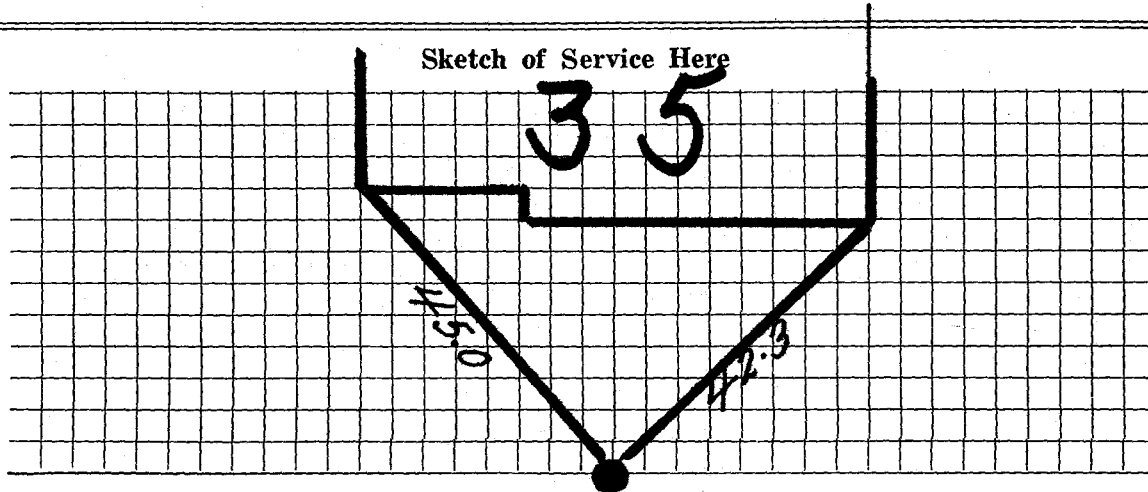

Connection made in \_\_\_\_\_ Street.

Work completed \_\_\_\_\_ 19

Remarks: