

WATER SERVICE RECORD

Name Robert Clements

Service No. 318

Address 40 Prospect Hill Road

Location

~~Renewal~~ ~~NEW SERVICE~~ *Comd. 12-19-55*


Date	Material	Amount	Total	Date	Amount
10-19-55	Labor	16 03		9-23-55	Deposited 100 00
	10% overhead	1 60	17 63	12-19-55	Paid 10 80
	120' - 1" copper tubing @ .645	77 40			<u>NON CHARGE</u> 110 80
	2 - 1" C. unions @ 2.26	4 52		10-19-55	Labor 3 70
	1 - 1" C x 3/4" I.W.H. stop & waste	4 50		10' - 1" copper tubing @ .645	6 45
	1 hr. trucking	75		1 - 1" C. corp-cock	6 80
	1 hr. town shovel	6 00		1 - 1" C. curb-cock	5 61
			110 80	1 box and rod	3 90
				1 - 3/4" straight tail pc.	50
				1 - 3/4" offset tail pc.	50
				1 hr. town shovel	6 00
				1 hr. trucking	75
					<u>34 21</u>

DATE _____

TOWN OF LEXINGTON — BOARD OF PUBLIC WORKS

WATER DIVISION

Sketch of Service Here

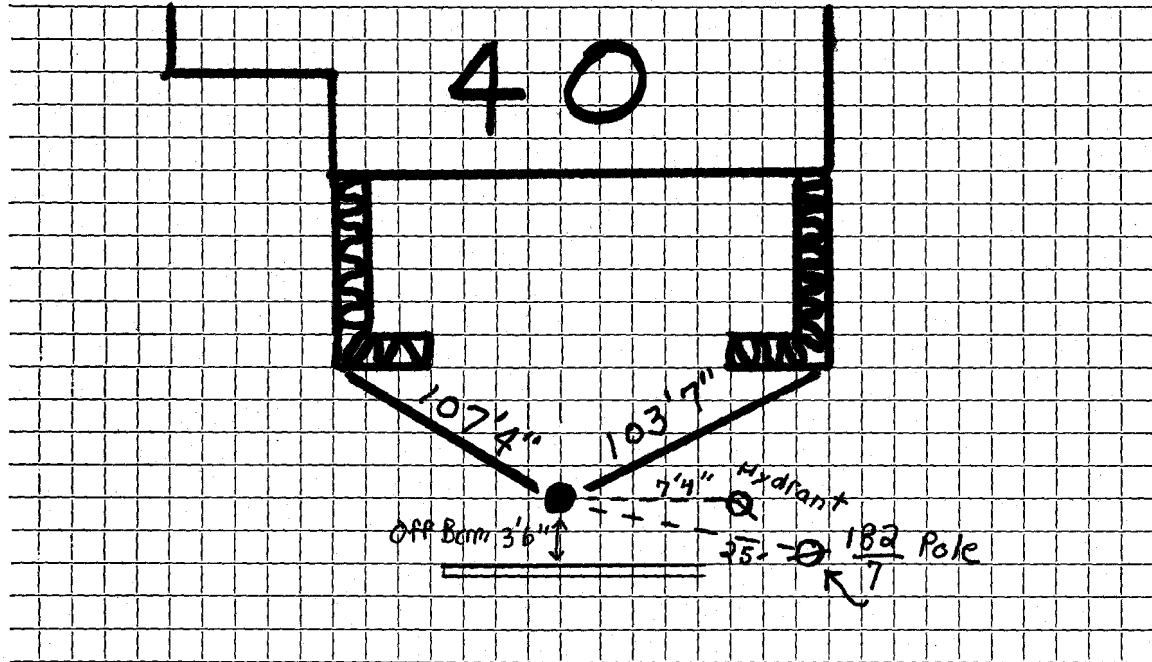

Connection made in Street. Work completed

Remarks: *Outside 10' 1" copper*

.....

.....