

Name **Leroy M. Hill**

Service No. ²³⁶ ~~95~~ **2285**

Address **880 Furnace Brook Parkway, Quincy**
44 Prospect Hill Rd.

Location **44 Prospect Hill Road**

Kind of Pipe

Size

Size of Main

~~Repair & Renewal~~ **New Service**

Location

Date	Material	Amount	Total	Date	Amount
<i>C. 11-19-29 for 55.00</i>	39 1" C.L. Pipe @.27	10 53		<i>Nov. 1 1929- Cash</i>	<i>55 -</i>
	2 1" L.L. Ells @.35	70			
	2 1" L.L. Coup. @.25	50			
	2 1" Br. Sp. Nip. @.30	60			
	1 S & W	3 00			
	Trucking	75	16 08		
<i>11/5/29</i>	17 Hrs. Labor @.55	9 35			
	2 " " @.60	1 20	10 55		
	15% Overhead		1 58		
			28 21		
<i>Dec. 31</i>	Labor <i>Return</i>		<i>26 79</i>		
			<i>55 00</i>		

Hadley Press, Inc. Lexington

DATE October 30, 1929

TOWN OF LEXINGTON—BOARD OF PUBLIC WORKS

WATER DIVISION

The undersigned applies for a supply of water at No. 44 Prospect Hill Road St. and hereby agrees to comply with the rules and regulations as now, or at any future time, established by the Board of Selectmen.

Am't. of Estimate \$ 55-

Owner

Leroy M Hill


Am't. Paid \$ _____

Address

880 Furnace Brook Parkway
Dunwoody

Builder _____

Sketch of Service Here

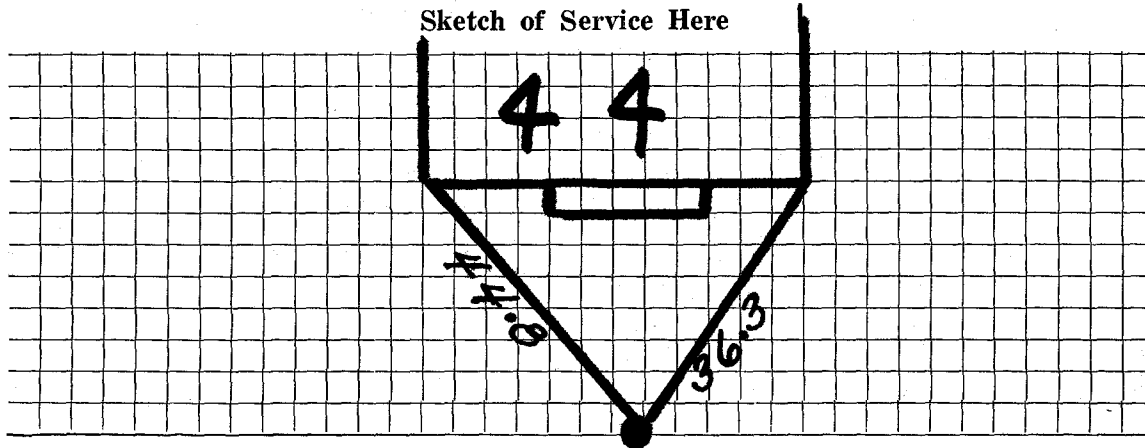

Connection made in _____ Street.

Work completed _____ 19

Remarks: