

## WATER SERVICE RECORD

Name Raymond Gittzus

Service No. 56

Address 46 Prospect Hill Road

# 2761

Location

~~Repair~~—Renewal—~~New Service~~

W.O.#1457

APR 8 1974


Date		Material	Amount	Total	Date	Amount
11/2/73		Labor	35.80		10-31-73	200.00
		10% O.H.	3.58	39.38	4-8-74	94.34
	37'	3/4" Copper @.98/ft.		36.26		105.64
	1	3/4" Wheel Valve		12.01		
	1	yd. of Loam		6.00		
	2	lbs. Grass Seed		2.00		
	1	Ground Clamp		.49		
	1	hr. Trucking		3.00		
	1	hr. Backhoe		6.50		
2-6-'91		Repair		\$105.64		
	11'	3/4" Copper				
	1	3/4" Coupling				

DATE \_\_\_\_\_

TOWN OF LEXINGTON — BOARD OF PUBLIC WORKS

WATER DIVISION

Sketch of Service Here

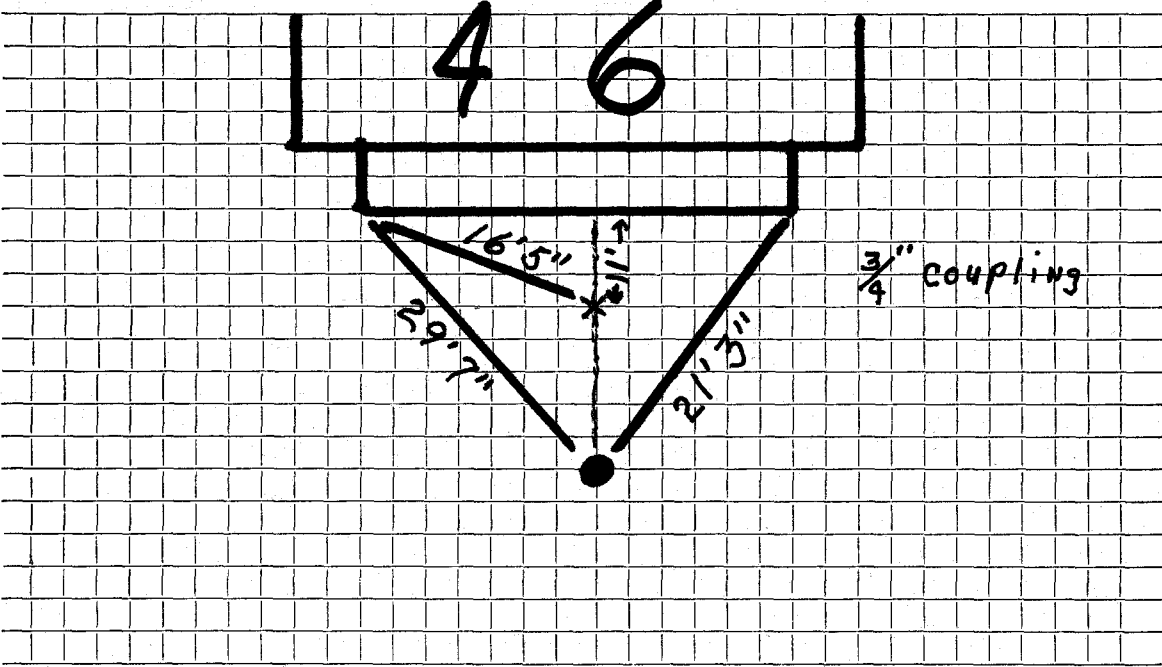

Connection made in ..... Street. Work completed .....

Remarks: *Original... Service... 6-28-27* .....

.....  
.....