

Name Clarence Cole

Service No. 13 3089

Address 50 Prospect Hill Road

Lexington 73, Mass.

Location 50 Prospect Hill Rd. # 2206

Kind of Pipe

Size

Size of Main

~~Repair - Renewal~~ - New Service

Location

Date	Material	Amount	Total	Date	Location	Amount
Jul. 25, '45	Labor	10 76		July 19, '45	<i>Deposited Paid Non-Charge</i>	30 00
	"	5 88	16 64	Oct 9, '45		<u>2 20</u>
	10% Overhead		1 66			32 20
	32' - $\frac{3}{4}$ " Copper Tubing		6 14	Jul. 26, '45	Labor	5 15
	1 - $\frac{3}{4}$ " C x $\frac{1}{2}$ " I.W.H. Stop & Waste		2 35	16' - $\frac{3}{4}$ " Copper Tubing		3 06
	Trucking 1 hr.	.75	75	1 - $\frac{3}{4}$ " C. Corp- Cock		2 48
	Patching 7 x 3		4 66	1 - $\frac{3}{4}$ " C. Curb Cock		2 75
			32 20	2 Tail Pieces		78
				1 Box & Rod		1 65
				Trucking 1 hr.		75
						<u>16 62</u>
	Labor				<i>Bill sent 10-1-45</i>	

Hadley Press, Inc., Lexington

DATE _____

TOWN OF LEXINGTON—BOARD OF PUBLIC WORKS

WATER DIVISION

The undersigned applies for a supply of water at No. _____ St. and hereby agrees to comply with the rules and regulations as now, or at any future time, established by the Board of Selectmen.

Am't. of Estimate \$ _____


Owner _____

Am't. Paid \$ _____

Address _____

Builder _____

Sketch of Service Here

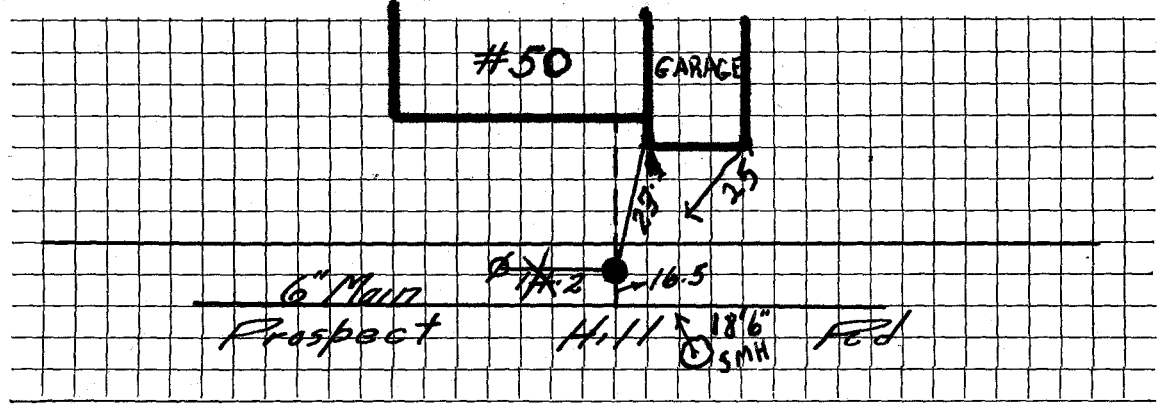

Connection made in _____ Street.

Work completed _____ 19

Remarks: