

Name Hazel I. Baker

Service No. ~~56~~ 2287

Address Trapelo Road, Waltham, Mass.

58 Prospect Hill Rd.

Location

<sup>58</sup>  
~~#60~~ Prospect Hill Road

Kind of Pipe

Size

Size of Main

Repair—Renewal—New Service

Location

Date 1939	Material	Amount	Total	Date	Amount
Oct. 6	1 hr. @ 60¢	60		Oct 21, 1939 Deposited	20 00
<i>Conc</i>	1 " @ 65¢	65	1 25	November 2, 1939 Refunded	5 47
<i>10/31/39</i>	10% Overhead		13		14 53
	38' 3/4" Copper Tubing @ 15¢		5 70		
	1 3/4" Stop & Waste		2 04		
	1 hr. trucking @ 75¢		75		
	Trench repairs		4 66		
			<u>\$ 14 53</u>		
	<b>Labor</b>				

Hadley Press, Inc., Lexington

DATE Aug 31, 1939

# TOWN OF LEXINGTON—BOARD OF PUBLIC WORKS

## WATER DIVISION

The undersigned applies for a supply of water at No. 58 60 Prospect Hill Rd and hereby agrees to comply with the rules and regulations as now, or at any future time, established by the Board of Selectmen.

Am't. of Estimate \$ owner 25.00 (Labor) Owner


Harold G. Baker

Am't. Paid \$ \_\_\_\_\_ Address

Trapelo Rd.  
Waltham

Builder Mr. Housinger

Sketch of Service Here

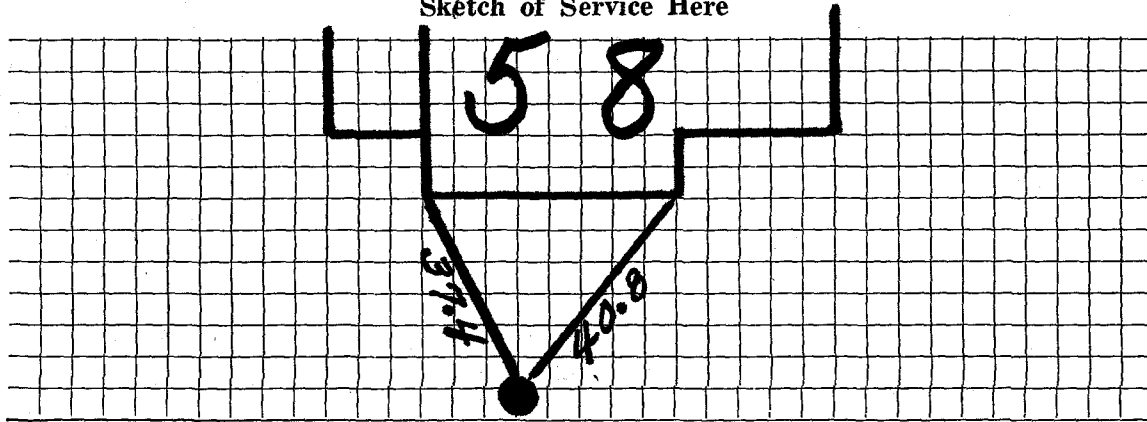

Connection made in \_\_\_\_\_ Street.

Work completed \_\_\_\_\_ 19

Remarks: