

Name Leonard Kenworthy

Service No. 2288

Address 54 Central Avenue, Everett

61 Prospect Hill Rd.

61 Prospect Hill Rd
~~53 Washuett Drive~~

4611

Location

Kind of Pipe

Size

Size of Main

~~Repair~~ ~~Renewal~~ - New Service

Location

Date
1939

Material

Amount

Total

Date

Amount

December 9
Com. 12. 20. 39

2 hrs. @ 60¢
2 " @ 65¢
10% Overhead
54' 3/4" Copper Tubing @ 15¢
1 3/4" C.xI S. & W.
2 hrs. trucking @ 75¢

1 20
1 30
2 50
25
8 10
2 10
1 50
14 45

December 7, 1939 Deposited
December 8, 1939 Refunded

26 00
11 55
14 45

Feb 2000

Bufflo Box

Labor

Hadley Press, Inc., Lexington

DATE Nov 28 '39

TOWN OF LEXINGTON—BOARD OF PUBLIC WORKS

WATER DIVISION #61 Prospect Hill Rd

The undersigned applies for a supply of water at No. 53 ~~Nashua Street~~ St. and hereby agrees to comply with the rules and regulations as now, or at any future time, established by the Board of Selectmen.

Am't. of Estimate \$ 26⁰⁰ *no estimate*

Owner Leonard Kenworthy


Am't. Paid \$ _____

Address St. Benet Avenue
Everett Mass

Builder _____

2540

Sketch of Service Here

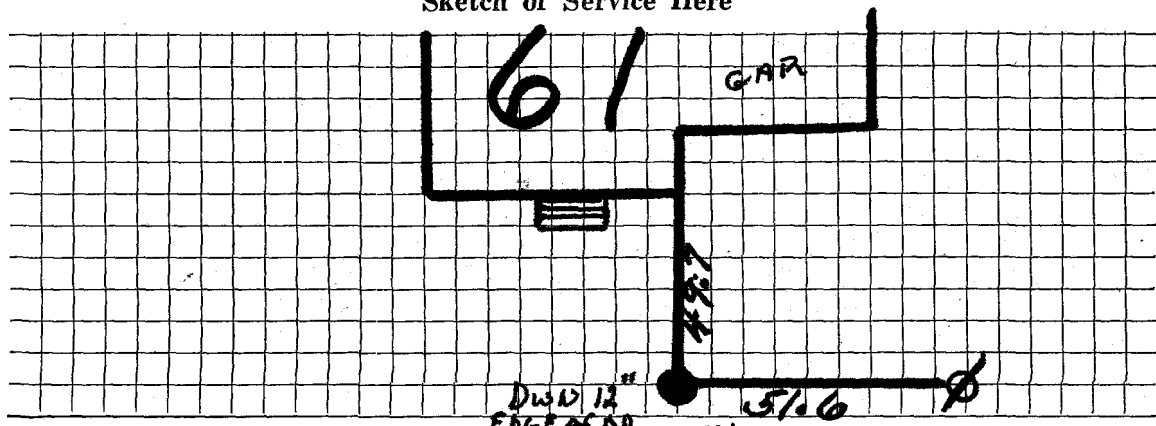

Connection made in _____ Street.

Bufflo Box

Work completed _____ 19

Remarks: