

Name Mrs. Ethel B. Sears

Service No. 51 2289

Address 7 Howe Street, Watertown

62 Prospect Hill

#62

Location Lot 45 Prospect Hill Road.

Kind of Pipe

Size

Size of Main

Repair—Renewal—New Service

Location

Date 1937

Material

Amount

Total

Date

Amount

7/19/37

2 hrs. @ 60¢

1 20

1 20

35 3/4" Cop. Tubing @ 25¢

8 75

1 3/4" Stop & Waste

3 75

2 hrs. Trucking @ 75¢

1 50

15 20

July 8, 1937 Deposited  
Sept 21, 1937 Reversed

24 50

Flat Rate:

35' @ 50¢

17 50

Trench Repairs

4 00

\$ 21 50

Labor

39'  
5' Patching

*Mad o J...*

DATE \_\_\_\_\_

# TOWN OF LEXINGTON—BOARD OF PUBLIC WORKS

## WATER DIVISION

The undersigned applies for a supply of water at No. #62 Prospect Hill Rd. St. and hereby agrees to comply with the rules and regulations as now, or at any future time, established by the Board of Selectmen.

|                      |              |           |
|----------------------|--------------|-----------|
| Am't. of Estimate \$ | <u>24.50</u> | <u>39</u> |
|                      |              | <u>50</u> |
|                      | <u>19.50</u> |           |
|                      | <u>5.00</u>  |           |
|                      | <u>24.50</u> |           |

Owner Elias T. Bears


Am't. Paid \$ \_\_\_\_\_

Address Prospect Hill Road - Lot No. 45

Builder \_\_\_\_\_

Lexington

Sketch of Service Here

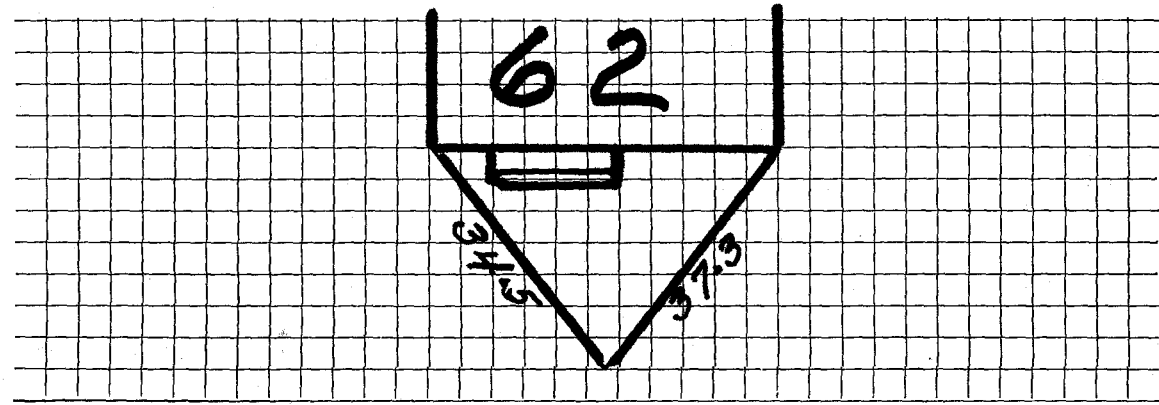

Connection made in \_\_\_\_\_ Street. Work completed \_\_\_\_\_ 19

Remarks: