

## WATER SERVICE RECORD

Name Robert H. Sproat

Service No. 45

Address 64 Prospect Hill Road

Location

~~Repair~~—Renewal—~~New Service~~ W.O.#1282

APR 8 1974


Date	Material	Amount	Total	Date	Amount	
9/12/73	Labor	68.40		9-11-73	Deposit	125.00
	10% O.H.	6.84	\$ 75.24	4-8-74	Refund	43.49
40'	3/4" Copper pipe @ .60		24.00			131.31
1	3/4" Wheel valve		9.57		<b>OUTSIDE</b>	
2	yds. Loam @ 5.00		10.00	9/12/73	Labor	70.00
3	lbs. Grass Seed @ 1.00		3.00	8/18/73	"	13.80
1	hr. Trucking		3.00		9' 3/4" Copper @.60	5.40
1	hr. Town Shovel		6.50			
			<u>\$131.31</u>			

DATE \_\_\_\_\_

TOWN OF LEXINGTON — BOARD OF PUBLIC WORKS

**WATER DIVISION**

Sketch of Service Here

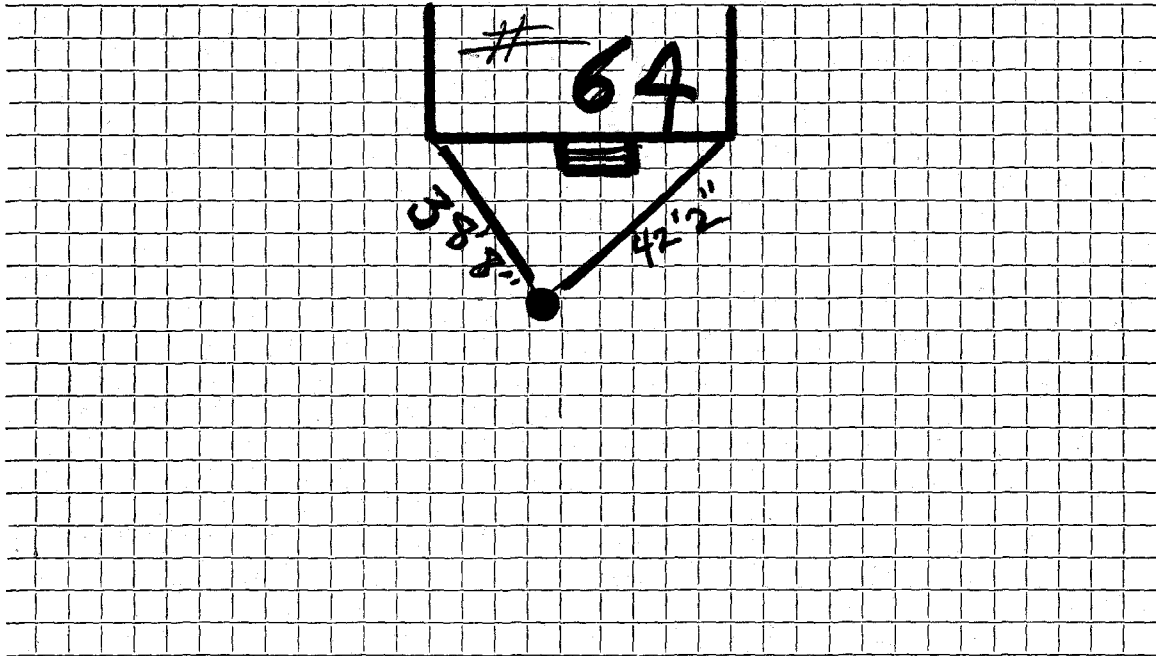

Connection made in ..... Street. Work completed .....

Remarks: .....

.....  
.....