

Name Mrs. Hazel I. Baker

Service No. 38 2292

Address Trapelo Road, Waltham, Mass.  
66 Prospect Hill Rd.

# 4579

Lot # 43

Location 66 Prospect Hill Road

Kind of Pipe

Size

Size of Main

Repair—Renewal—New Service

Location

Date  
1938

Material

Amount

Total

Date

Amount

Aug. 5

2 hrs @ 60¢

1 20

August 3, 1938 Deposited

20 00

43' 3/4" C. Tubing @ 20¢

8 60

January 4, 1939 Paid

~~24 84~~

1 3/4" S. & W.

3 75

Trucking - 2 hrs, @ 75¢

1 50

24 84

15 05

Flat Rate:

43' @ 50¢

21 50

Trench Repairs

3 34

\$ 24 84

Bill sent 9/30/38  
" " 12/17/38

Labor

DATE August 3 1938

TOWN OF LEXINGTON—BOARD OF PUBLIC WORKS  
**WATER DIVISION**

The undersigned applies for a supply of water at No. 66 Prospect Hill Rd. and hereby agrees to comply with the rules and regulations as now, or at any future time, established by the Board of Selectmen.

Am't. of Estimate \$ 27<sup>00</sup>


Owner Hazel I. Baker

Am't. Paid \$ \_\_\_\_\_

Address 66 Prospect Hill Rd.  
Lexington  
"Fair Oaks"

Builder \_\_\_\_\_

Sketch of Service Here

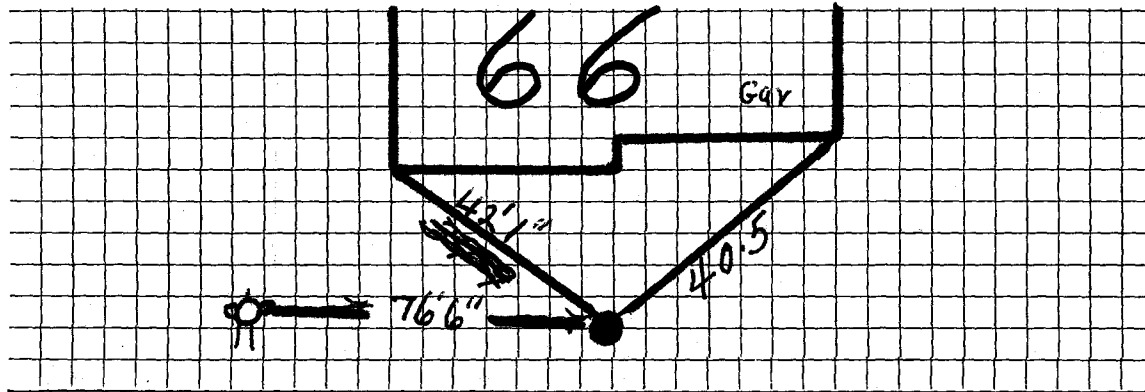

Connection made in \_\_\_\_\_ Street.

Work completed \_\_\_\_\_ 19

Remarks: