

Name Mary H. Cornell

Service No.

245

Address 72 Prospect Hill Road

# 5808

Lexington, Mass.

Location 72 Prospect Hill Rd.

5838

5839

72 Prospect Hill Rd.

Kind of Pipe

Size

Size of Main

~~XXXXXXXXXX~~ New Service

Location

Date	Material	Amount	Total	Date	Location	Amount
Nov. 12, '48	Labor	6 43	6 43	Oct 18, '48	Deposited	60 00
	10% Overhead		64	Dec. 31, '48	Deposited	20 32
	42' - 3/4" Copper Tubing @.255	10 71			Non-Charge	37 68
	1 - 3/4" C x 1/2" I.W.H. S & W	3 15		Nov. 12, '48	Labor	2 50
	Littlefield Shovel 2 hrs. @7.00	14 00		10' - 3/4" Copper Tubing @.255		2 55
	Trucking 1 hr. @.75		75	1 - 3/4" C Corp-cock		3 00
	Patching 4 x 3		4 00	1 - 3/4" C x 3/4" C Curb-cock		3 68
			39 68	1 - Box & Rod		3 55
				1 - 1/2" Offset Tail Piece		30
				1 - 1/2" Straight Tail Piece		30
				Trucking 1 hr. @.75		75
						16 63
	Labor					

DATE \_\_\_\_\_

TOWN OF LEXINGTON - BOARD OF PUBLIC WORKS

**WATER DIVISION**

The undersigned applies for a supply of water at No..... St. and hereby agrees to comply with the rules and regulations as now, or at any future time, established by the Board of Selectmen.

Am't of Estimate \$.....

Owner .....


Am't Paid \$.....

Address .....

Builder .....

.....

Sketch of Service Here

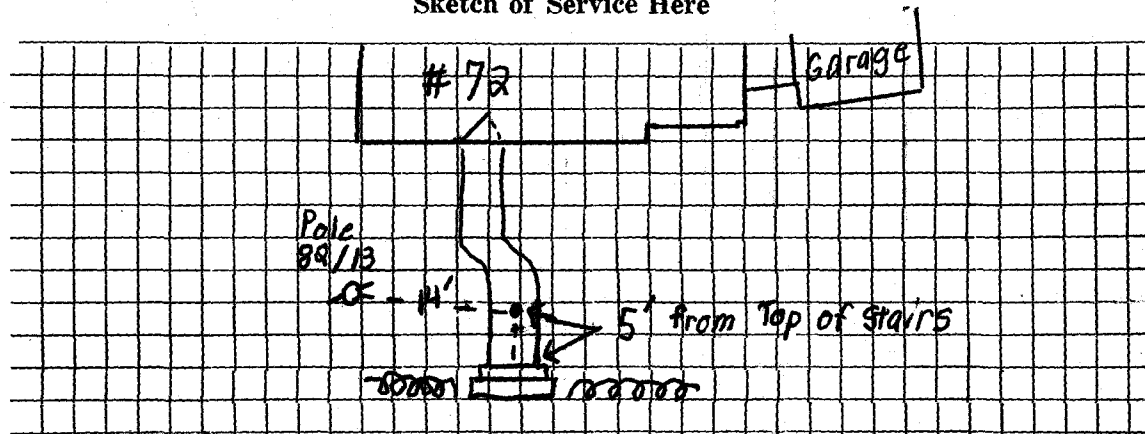

Connection made in ..... Street.

Work completed .....19

Remarks: