

WATER SERVICE RECORD

Name Harry G. Berglund

Service No. 267

Address 75 Prospect Hill Road

2101

Location

~~XXXXXXXXXX~~ New Service

Comm. 12-13-54

Date	Material	Amount	Total	Date	Amount
11/5/54	Labor	1 85		11-21-54	Deposited 25 00
	10% overhead	19	2 04	12-17-54	Paid (20 9
	58' - 3/4" copper tubing @ .35	20 30			NON CHARGE 27 09
	1 - 3/4" C x 1/2 I.W.H. stop & waste	4 00		11/5/54	Labor 1 85
	1 hr. trucking		75	10' - 3/4" copper tubing @ .35	3 50
			27 09	1 - 3/4" C. corp-cock	4 33
				1 - 3/4" C. curb-cock	4 67
				1 box and rod	3 90
				1 - 1/2 straight tail pc.	50
				1 - 1/2 offset tail pc.	50
				1 hr. trucking	75
					20 00


Bill sent 12-14-54

DATE _____

TOWN OF LEXINGTON — BOARD OF PUBLIC WORKS

WATER DIVISION

Sketch of Service Here

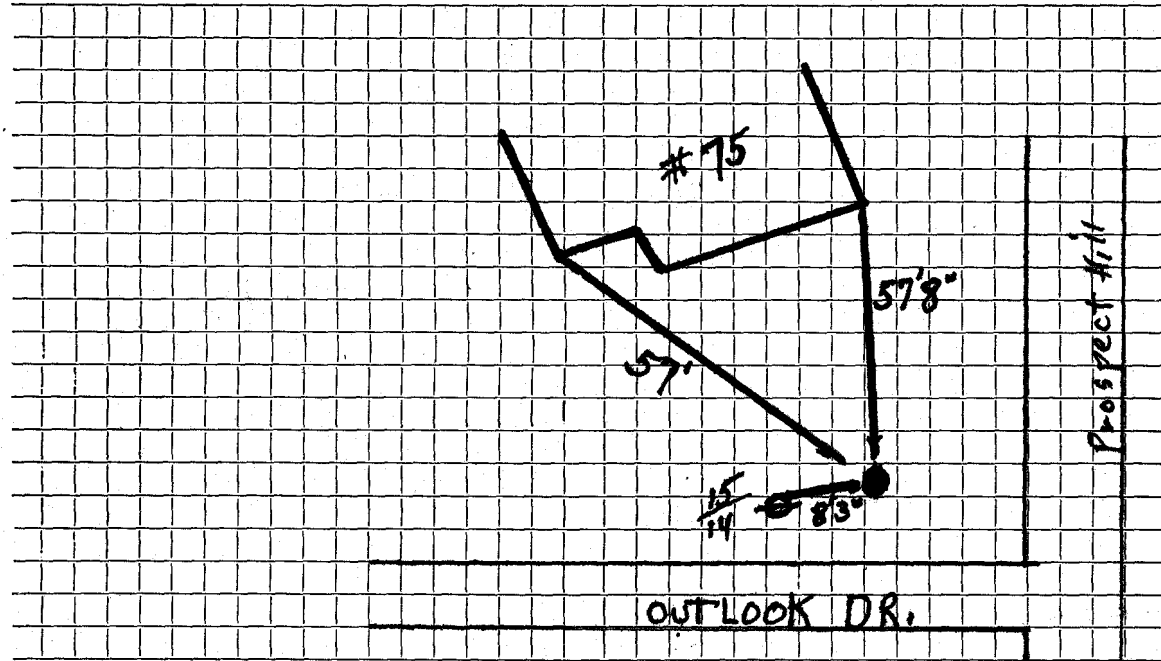

Connection made in Street. Work completed

Remarks:

.....

.....