

WATER SERVICE RECORD

7670

Name

Service No.

Address 9 Prospect Hill Road

Location

~~Repair~~ - Renewal - ~~New Service~~


Date	Material	Amount	Total	Date	Amount
8-27-35	63' 1" C.L. Pipe				
	4 1" L.L. Coupling				
	1 1" L.L. ELL				
	1 1" Brass Nipple			3/11/56 Labor	33 00
	1 Stop & Waste			24' 3/4" Copper tubing @.4396	10 55
				4 Hrs. Littlefield Shov. @8.50	34 00
				2 Hrs. trucking @.75	1 50
				1 3/4" C Corp Cock	4 64
				1 3/4" C Curb Cock	5 94
				1 1" Repair Clamp	1 60
				20 x 3 Patching	20 00
					111 23

NON CHARGE

TOWN OF LEXINGTON — BOARD OF PUBLIC WORKS

WATER DIVISION

Sketch of Service Here

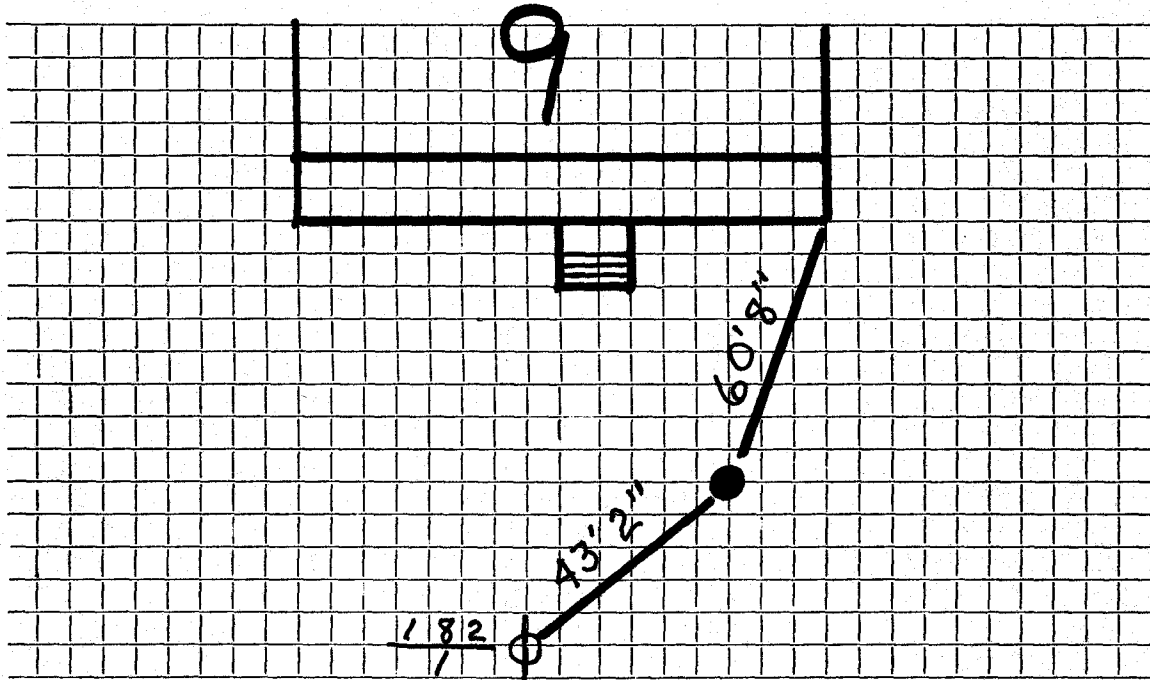

Connection made in Street. Work completed

Remarks:
.....
.....