

WATER SERVICE RECORD

Name **Albert Fisher**

Service No. **117**

Address **12 Rangeway Road**

Location **Lexington, Mass.**

~~Repair-Replace~~ New Service *Com. 9-24-51*


Date	Material	Amount	Total	Date	Amount
6-16-51	Labor	1 1/49	1 1/49	6-4-51	Deposited 20 00
	10% Overhead		15	10-10-51	Paid 2 78
	45'-3/4" Copper Tubing @.326		14 67		22 78
	1-3/4"Cx1/2 I.W.H. S&W		4 00		No Charge
	1-3/4"Cx3/4"C Union (3 pts)		1 72	6-16-51	Labor 4 03
	1 Hr. Trucking		75	22'-3/4" Copper Tubing @.326	7 17
			22 78	1-3/4"Cx3/4" C. Corp-Cock	4 33
				1-3/4"Cx3/4" C. Curb-Cock	4 67
				1 Box & Rod	4 68
				1-1/2 Straight Tail Piece	50
				1-1/2 Offset Tail Piece	50
				2 Hr. Littlefield Shovel 7.00	14 00
				1 Hr. Trucking	75
					40 63
					<i>Bill sent 9-24-51</i>

DATE _____

TOWN OF LEXINGTON — BOARD OF PUBLIC WORKS

WATER DIVISION

Sketch of Service Here

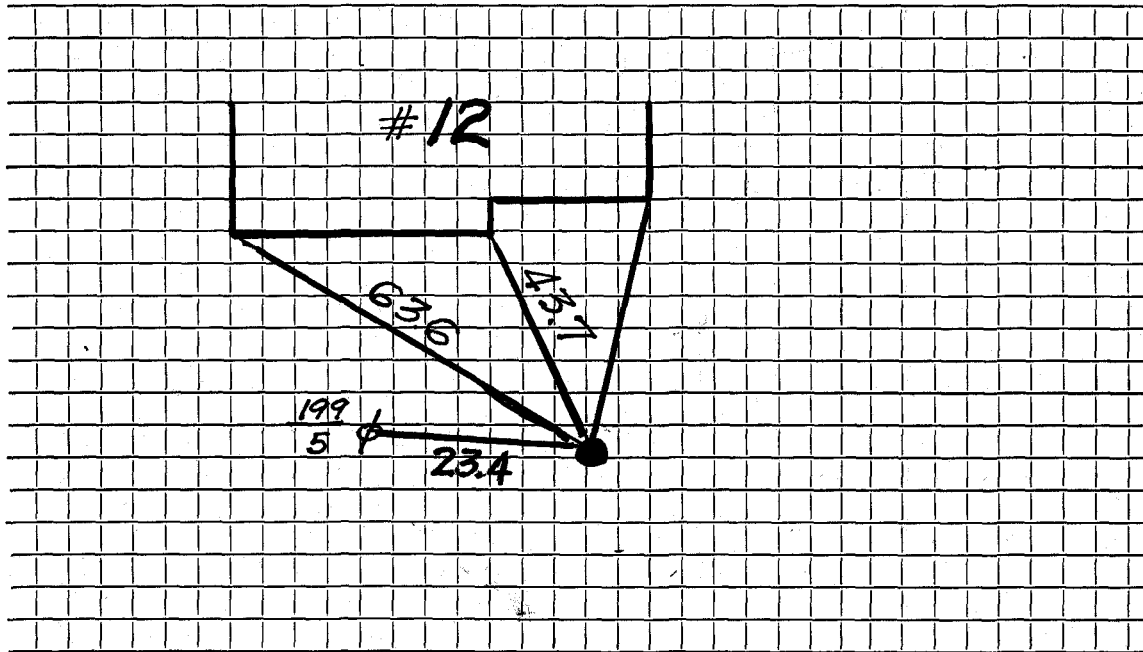

Connection made in Street. Work completed

Remarks:
.....
.....