


TOWN OF LEXINGTON — BOARD OF PUBLIC WORKS

WATER DIVISION

16/18
RANGWAY Rd

Sketch of Service Here

Lex: HAB 16 RANGWAY R.D.

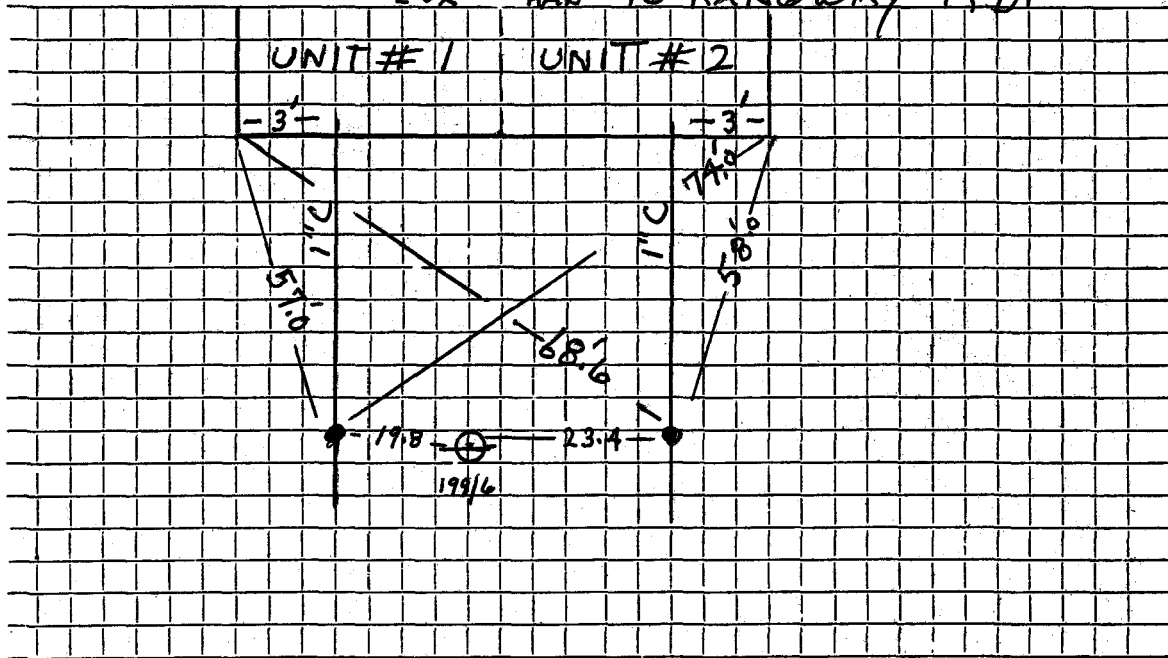

Connection made in Street.

Work completed 10/18/04 J. McLaughlin

Remarks:
.....
.....