

WATER SERVICE RECORD

Name Michael D. Saunders

Service No. 45

Address 21 Rangeway Road

Location

~~Repair of Sewer~~ - New Service D'Errico #3504

JAN 21 1980


Date	Material	Amount	Total	Date	Amount
12-12-79	Labor	53.36		12-31-79	120.00
12-14-79	Labor	133.40	186.76	1-1-80	185.00
	10% O.H.	18.68	205.44		305.00
10'	3/4" Copper tubing @.94		9.40		
1	3/4" Corp.		12.40		
1	3/4" Curb		17.73		
1	Box & Rod		10.95		
4	hrs. Trucking @3.00		12.00		
2	hrs. Backhoe @6.50		13.00		
10'	6" Transite @1.62		16.20		
1	11 1/4" Bend		8.07		
			305.29		
12-20-79	57' 3/4" Copper tubing				

DATE _____

TOWN OF LEXINGTON — BOARD OF PUBLIC WORKS

WATER DIVISION

Sketch of Service Here

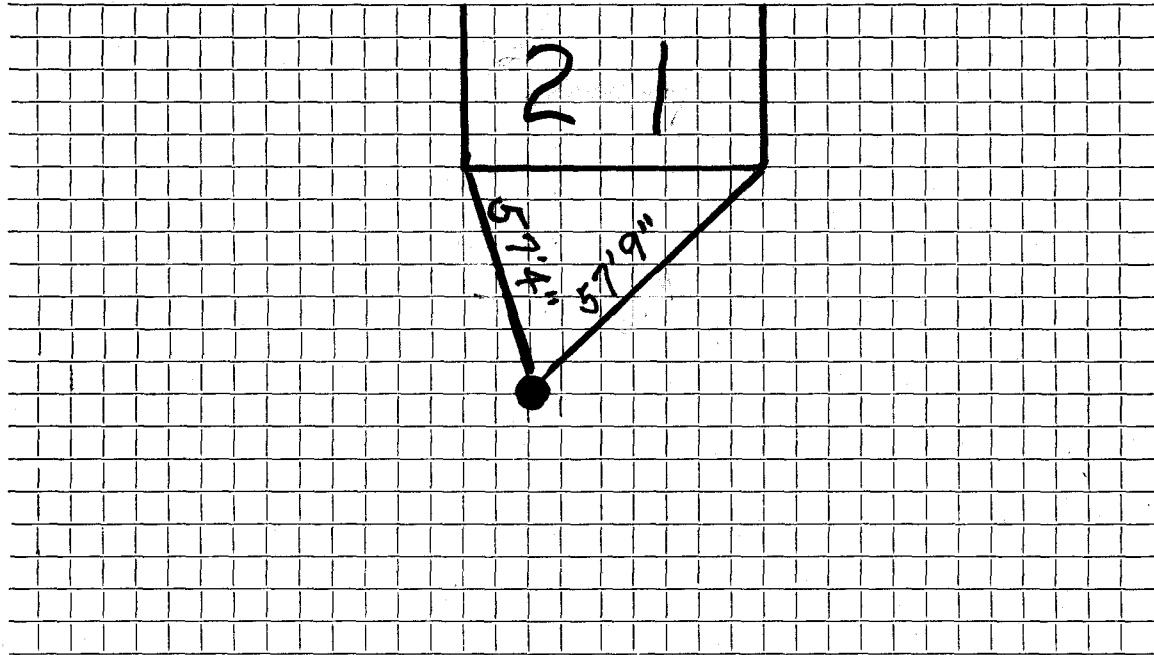

Connection made in Street. Work completed

Remarks:
.....
.....