

Name Mrs. George Coulombe

Service No. 25

Address 23 Rangeway

Lexington, Mass.

Location 23 Rangeway

Kind of Pipe

Size

Size of Main

~~Renewal~~—New Service

Com. 5/22/50

Location

Date	Material	Amount	Total	Date	Amount
Apr. 20, '50	Labor	20 62	20 63	Feb 18 '50	50 00
	10% Overhead		2 06	May 2 '50	7 16
	1/4' - 3/4" Copper Tubing @.23		10 12		42 84
	1 - 3/4" C x 1/8" I.W.H. S&W		3 29	Apr. 20, '50	25 00
	Town Shovel 2 hrs. @ 3.00		6 00	15' - 3/4" Copper Tubing @.23	3 45
	Trucking 1 hr. @.75		75	1 - 3/4" C Corp-cock	3 15
			42 84	1 - 3/4" C x 3/4" C Curb-cock	3 85
				1 - Box & Rod	3 70
				1 - 3/8" Straight Tail Piece	38
				1 - 1/2" Offset Tail Piece	38
				Town Shovel 2 hrs. @ 3.00	6 00
				Trucking 1 hr. @/75	75
	Labor				46 66

DATE _____

TOWN OF LEXINGTON - BOARD OF PUBLIC WORKS

WATER DIVISION

The undersigned applies for a supply of water at No..... St. and hereby agrees to comply with the rules and regulations as now, or at any future time, established by the Board of Selectmen.

Am't of Estimate \$.....

Owner


Am't Paid \$.....

Address

Builder

.....

Sketch of Service Here

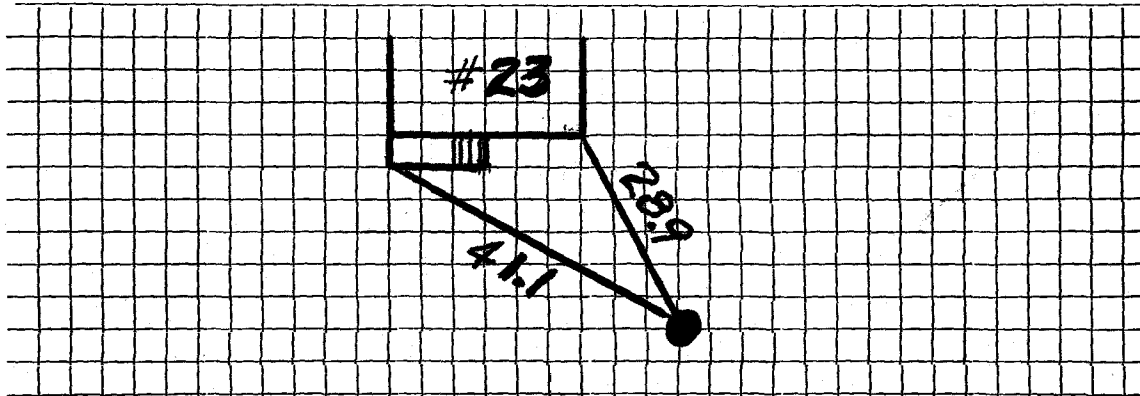

Connection made in Street.

Work completed19

Remarks: