

Name Philip Gillingham

Service No. 22

Address 27 Rangeway Street

Lexington, Mass.

Location 27 Rangeway

Kind of Pipe

Size

Size of Main

~~Repairs-Renewals~~ New Service

Conn. 5/22/50

Location

Date	Material	Amount	Total	Date	Amount
Apr. 18, '50	Labor	3 00	3 00	Feb 18 '50	35 00
	10% Overhead		30	May 25 '50	17 31
	45' - 3/4" Copper Tubing @.23		10 35		17 69
	1 - 3/4" C x 1/2" I.W.H. S&W		3 29		No Charge
	Trucking 1 hr. @.75		75	Apr. 18, '50	5 26
			17 69	26' - 3/4" Copper Tubing @.23	5 98
				1 - 3/4" C Corp-cock	3 15
				1 - 3/4" C x 3/4" C Curb-cock	3 85
				1 - Box & Rod	3 70
				1 - 1/2" Offset Tail Piece	38
				1 - 1/2" Straight Tail Piece	38
				Town Shovel 1 hr. @ 3.00	3 00
				Trucking 1 hr. @.75	75
	Labor				26 45

DATE _____

TOWN OF LEXINGTON – BOARD OF PUBLIC WORKS

WATER DIVISION

The undersigned applies for a supply of water at No..... St. and hereby agrees to comply with the rules and regulations as now, or at any future time, established by the Board of Selectmen.

Am't of Estimate \$.....

Owner


Am't Paid \$.....

Address

Builder

.....

Sketch of Service Here

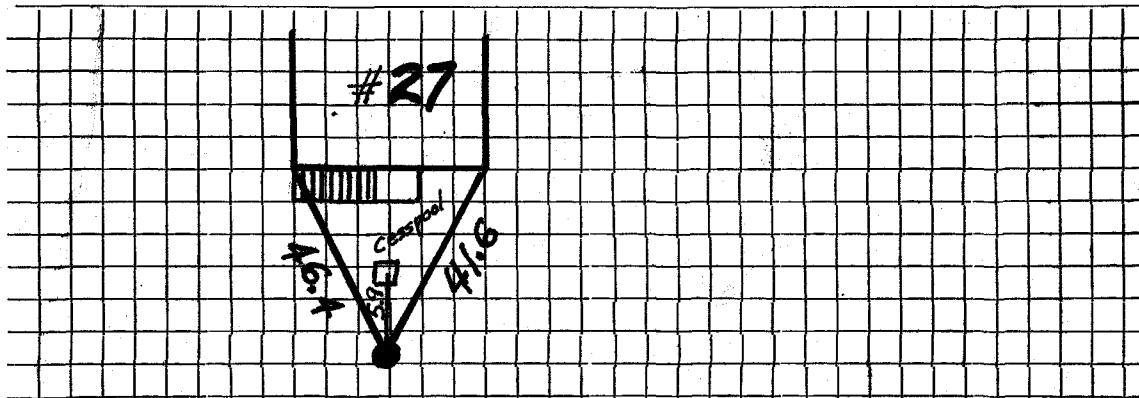

Connection made in Street.

Work completed19

Remarks: