

Name William R. Reid

Service No. 23

Address 4 Rangeway

# 2175

Lexington, Mass.

Location 4 Rangeway

Kind of Pipe

Size

Size of Main

Rangehead—New Service

Com. 5/22/50

Location

Date	Material	Amount	Total	Date		Amount
Apr. 21, '50	Labor	1 50	1 50	Feb 13 '50	Reprinted	20 00
	10% Overhead		15	May 25 '50	Revised	6 26
	35' - 3/4" Copper Tubing @.23		8 05		No Charge	13 74
	1 - 3/4" C x 1/2" I.W.H. S&W		3 29	Apr. 21, '50	Labor	8 47
	Trucking 1 hr. @.75		75	22' - 3/4" Copper Tubing @.23		5 06
			13 74	1 - 3/4" C Corp-cock		3 15
				1 - 3/4" C x 3/4" C Curb-cock		3 85
				1 - Box & Rod		3 70
				1 - 1/2" Offset Tail Piece		38
				1 - 1/2" Straight Tail Piece		38
				Town Shovel 1 hr. @ 3.00		3 00
				Trucking 1 hr. @.75		75
	Labor					28 74

TOWN OF LEXINGTON – BOARD OF PUBLIC WORKS

**WATER DIVISION**

The undersigned applies for a supply of water at No..... St. and hereby agrees to comply with the rules and regulations as now, or at any future time, established by the Board of Selectmen.

Am't of Estimate \$.....

Owner .....


Am't Paid \$.....

Address .....

Builder .....

.....

Sketch of Service Here

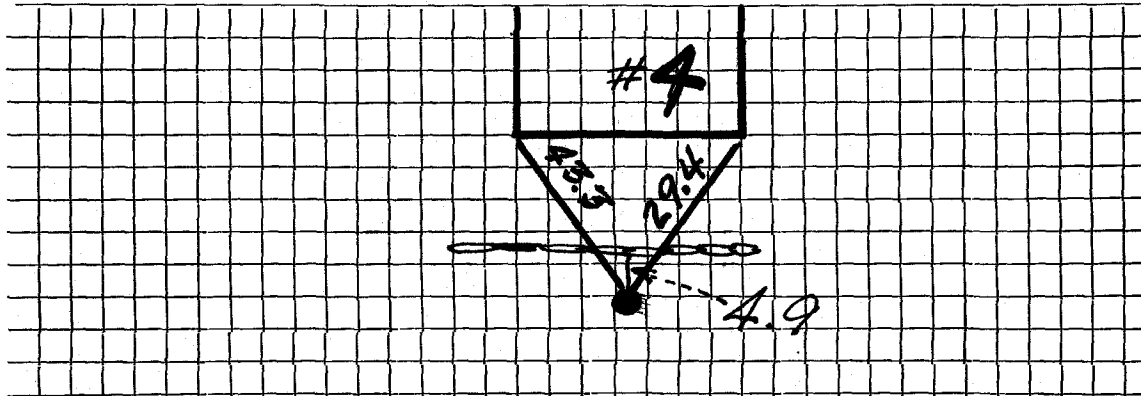

Connection made in ..... Street.

Work completed .....19

Remarks: