

Name Thomas Martin

Service No. 17 #5094

Address 7 Rangeway

Lexington, Mass.

Location 7 Rangeway

Kind of Pipe

Size

Size of Main

Repairs—Renewal—New Service

Comm. 5/22/50

Location

Date	Material	Amount	Total	Date	Amount
Apr. 18, '50	Labor	1 50	1 50	Feb 10 '50	20 00
	10% Overhead		15	May 25 '50	9 02
	23' - 3/4" Copper Tubing @.23		5 29		10 98
	1 - 3/4" C x 1/2" I.W.H. S&W		3 29	Apr. 18, '50	6 75
	Trucking 1 hr. @.75		75	14' - 3/4" Copper Tubing @.23	3 22
			10 98	1 - 3/4" C Corp-cock	3 15
				1 - 3/4" C x 3/4" C Curb-cock	3 85
				1 - Box & Rod	3 70
				1 - 1/2" Offset Tail Piece	38
				1 - 1/2" Straight Tail Piece	38
				Town Shovel 1 hr. @ 3.00	3 00
				Trucking 1 hr. @.75	75
	Labor				25 18

DATE _____

TOWN OF LEXINGTON - BOARD OF PUBLIC WORKS

WATER DIVISION

The undersigned applies for a supply of water at No..... St. and hereby agrees to comply with the rules and regulations as now, or at any future time, established by the Board of Selectmen.

Am't of Estimate \$.....

Owner


Am't Paid \$.....

Address

Builder

.....

Sketch of Service Here

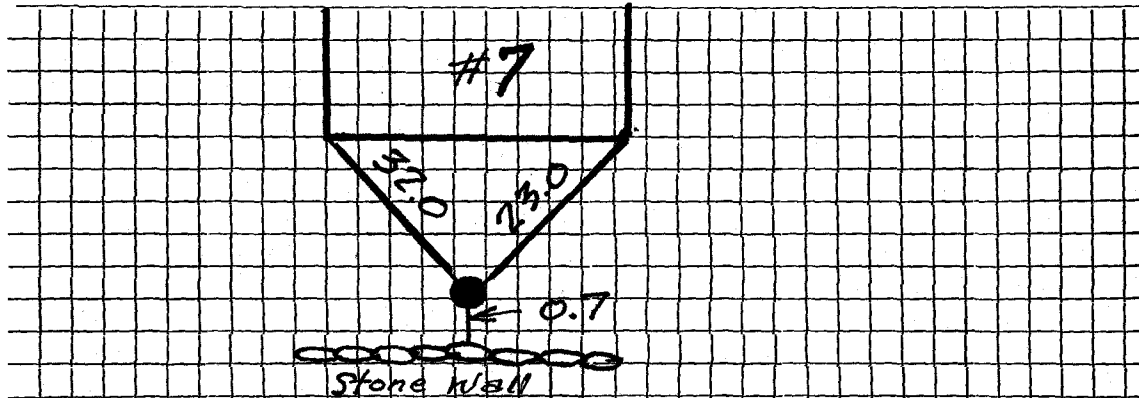

Connection made in Street.

Work completed19

Remarks: