

Name James MacDonald

Service No. 30 #5013

Address 8 Rangeway

#5014

Lexington, Mass.

Location 8 Rangeway

Kind of Pipe

Size

Size of Main

~~Renewal~~—New Service

Com. 5/22/50

Location

Date	Material	Amount	Total	Date	Amount
Apr. 12, '50	Labor	9 20	9 20	Mar 16 '50	35 00
	10% Overhead		92	May 20 '50	15 55
	23' - 3/4" Copper Tubing @.23		5 29		19 45
	1 - 3/4" C x 1/2" I.W.H. S&W		3 29	Apr. 14, '50	10 00
	Trucking 1 hr. @.75		75	26' - 3/4" Copper T <sub>u</sub> bing @.23	5 98
			19 45	1 - 3/4" C Corp-cock	3 15
				1 - 3/4" C x 3/4" C Curb-cock	3 85
				1 - Box & Rod	3 70
				1 - 1/2" Offset Tail Piece	38
				1 - 1/2" Straight Tail Piece	38
				Town Shovel 1 hr. @ 3.00	3 00
				Trucking 1 hr. @.75	75
	Labor				31 19

DATE \_\_\_\_\_

TOWN OF LEXINGTON – BOARD OF PUBLIC WORKS

**WATER DIVISION**

The undersigned applies for a supply of water at No..... St. and hereby agrees to comply with the rules and regulations as now, or at any future time, established by the Board of Selectmen.

Am't of Estimate \$.....

Owner .....


Am't Paid \$.....

Address .....

Builder .....

.....

Sketch of Service Here

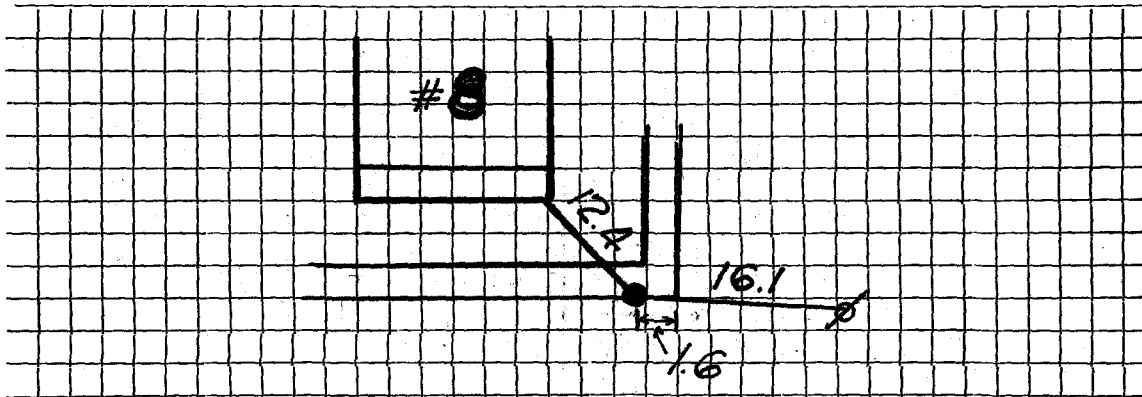

Connection made in ..... Street.

Work completed .....19

Remarks: