


DATE 9/6/2016

TOWN OF LEXINGTON — BOARD OF PUBLIC WORKS
WATER DIVISION

Sketch of Service Here

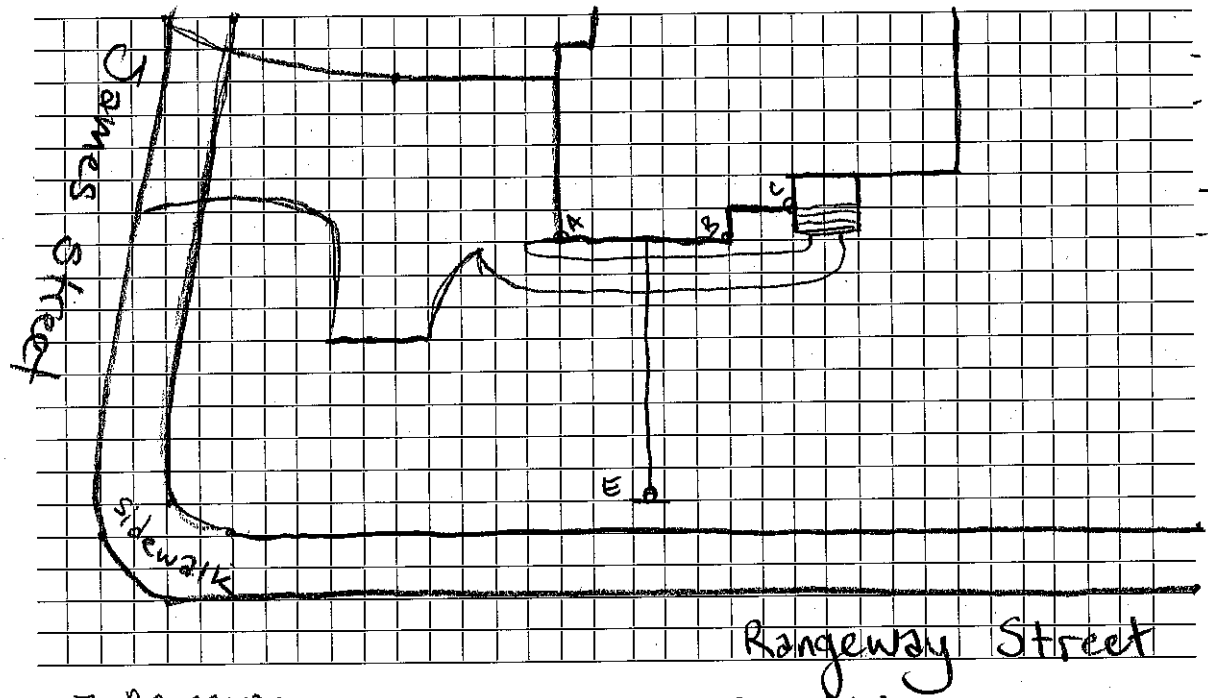

- E = 1" Curb Stop
- Existing 3/4" at 4.5" depth
- AE = 38'
- BE = 48.5'

Connection made in... 7. Rangeway Street. Work completed

Remarks:

.....