

WATER SERVICE RECORD

Name Joseph Marajo

Service No. 151

Address 15 Rawson Avenue

Location

1613

~~Renewal~~ ~~Renewal~~ - New Service

WO # 7699


Comm 1-14-63

Date	Material	Amount	Total	Date	Amount	
11-6-62	Labor	3.91		10-31-62	Deposit	50.00
	10% O.H.	.39	4.30	1-14-63	Refund	16.43
55'	3/4" Transite pipe @.42		23.10			33.57
1	3/4" CX $\frac{1}{2}$ I.W.H. Stop & Waste		6.17			
			33.57		NON CHARGE	
				7-21-61	Labor	3.92
					12' 3/4" Copper Tubing @.42	5.04
					1 3/4" C Corp Cock	4.91
					1 3/4" Curb Cock	6.28
					1 Box & Rod	4.90
						25.05
				11-6-62		
					1 $\frac{1}{2}$ Straight tailpiece	.50
					1 $\frac{1}{2}$ Offset tailpiece	.50
						26.05

TOWN OF LEXINGTON — BOARD OF PUBLIC WORKS

WATER DIVISION

Sketch of Service Here

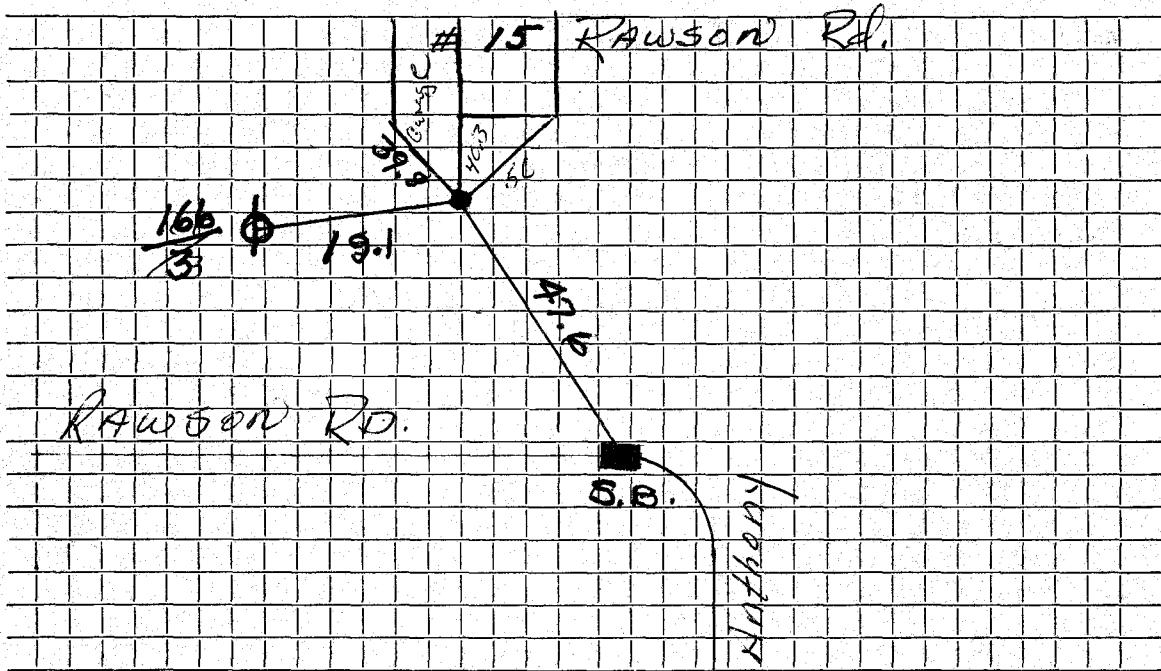

Connection made in Street. Work completed

Remarks:
.....
.....