

## WATER SERVICE RECORD

#5805

Name Joe Marajo

Service No. 124

Address 19 Rawson Avenue

Location

~~Improvement~~ New Service

W.O. #7601

Comm 12-16-62


Date	Material	Amount	Total	Date	Amount	
10-17-62	Labor	4.26		9-17-62	Deposit	30.00
	10% O.H.	.43	4.69	12-16-62	Re-Summed	11.53
	60' 3/4" Copper tubing @ 42		25.20			38.47
	1 3/4" CX 1/2 I/W.H. Stop & Waste		6.17			
	1 1" X 3/4" 3 Part Union		2.41			
			38.47			
				10-17-62	1/2 Straight tailpiece	50
					1 1/2 Offset Tailpiece	50
						1.00

DATE \_\_\_\_\_

TOWN OF LEXINGTON — BOARD OF PUBLIC WORKS

WATER DIVISION

Sketch of Service Here

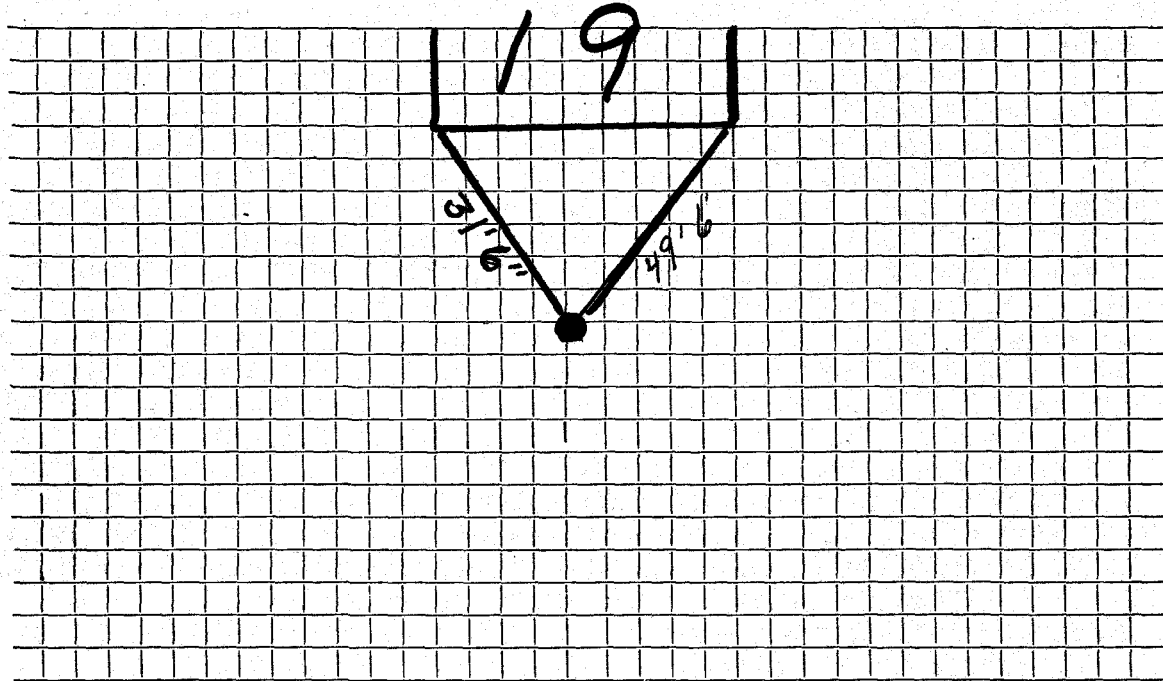

Connection made in ... B.O.W. .... Street. Work completed .....

Remarks: .....

.....

.....