




DATE June 2020

TOWN OF LEXINGTON — BOARD OF PUBLIC WORKS

WATER DIVISION

Sketch of Service Here

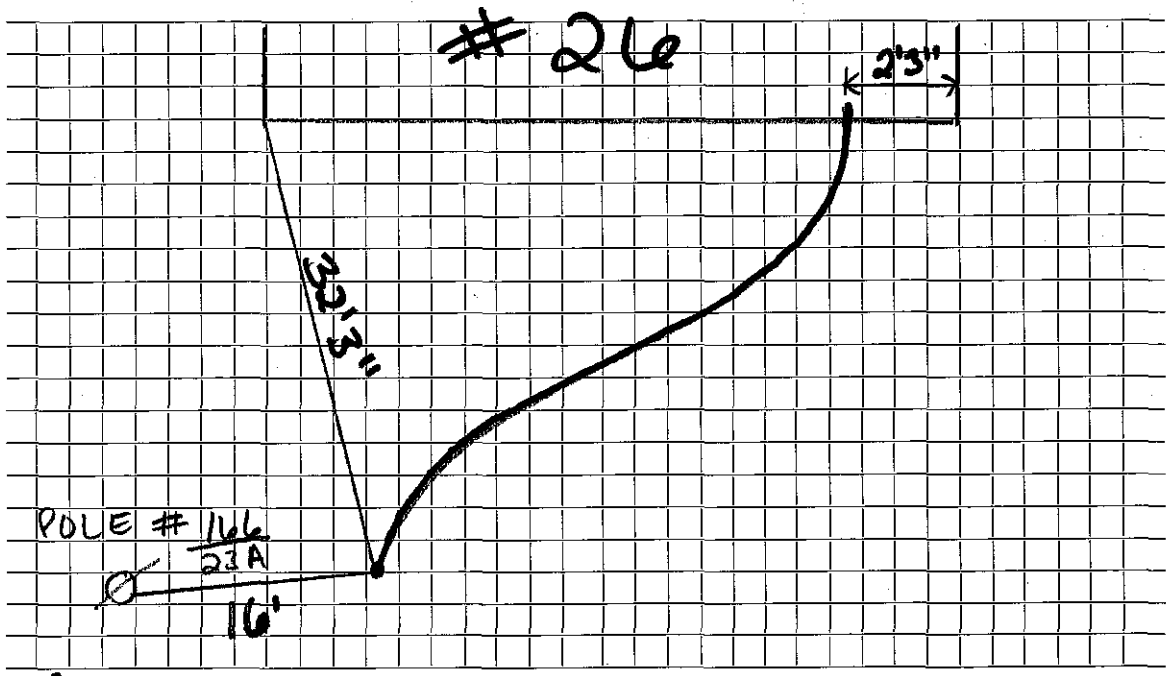

Connection made in Rawson Ave Street. Work completed .....

Remarks: .....

depth @ foundation = 5'      depth @ curb stop = 5' 3"