

Name Donato Pierro

Service No.

135

Address 28 Rawson Avenue

Lexington, Mass.

Location 28 Rawson Avenue

Kind of Pipe

Size

Size of Main

~~Repair~~ Renewal - ~~New Service~~

Com. 9-26-49

Location

Date	Material	Amount	Total	Date	Amount
Jul. 20, '49	Labor	2 35	2 35	July 14 '49	10 00
	10% Overhead		24		
	16' - 3/4" Copper Tubing @ .24		3 84		No Charge
	1 - 3/4" C x 1/2" I.W.H. S&W		3 29	Jul. 20, '49	2 35
	Trucking 1 hr. @ .75		75	24' - 3/4" Copper Tubing @ .24	5 76
			10 47	1 - 3/4" C Adapter	1 50
				1 - 3/4" C x 3/4" C Curb-cock	3 85
				Trucking 1 hr. @ .75	75
				1 - 1/2" Offset Tail Piece	37
					14 58
	Labor				

DATE _____

TOWN OF LEXINGTON – BOARD OF PUBLIC WORKS

WATER DIVISION

The undersigned applies for a supply of water at No..... St. and hereby agrees to comply with the rules and regulations as now, or at any future time, established by the Board of Selectmen.

Am't of Estimate \$.....

Owner


Am't Paid \$.....

Address

Builder

.....

Sketch of Service Here

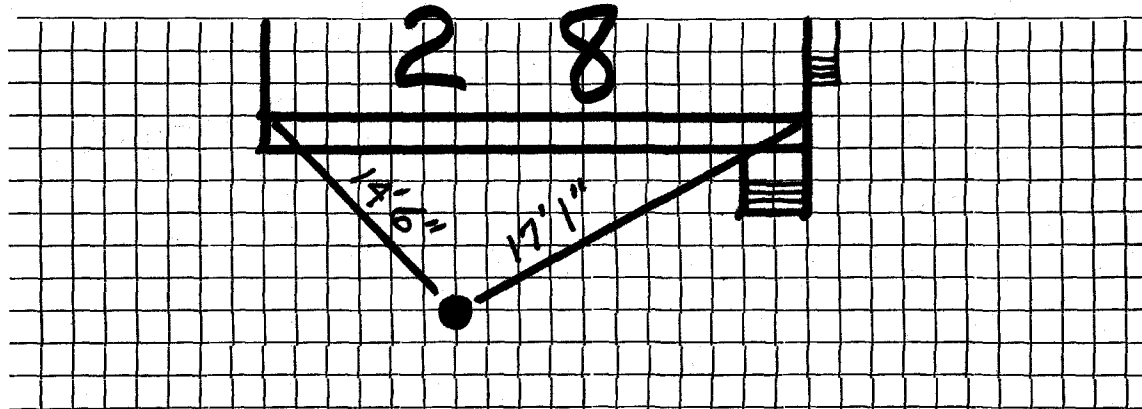

Connection made in Street.

Work completed19

Remarks: