

WATER SERVICE RECORD

Name

Service No.

Address

Location 34 Rawson Ave.

Repair—Renewal—New Service


Date		Material	Amount	Total	Date	Material	Amount
4-25-	58						
	120'	3/4" Copper					
	1	3/4" C. X 1/2" l.w.h. Stop & Waste			8-4-	49	Renewal - Main To Curb
	1	3/4" C. - 3 Part Union				40'	1" Copper
						1	1" C. Adapter
						1	1" C. X 1" l. Curb Cock
						1	1" C. X 1" C. - 3 Part Union
						1	Box & Rod
					4-24-	58	
						1	1" Cl. Br. Nipple
						1	3/4" C. X 1" l. - 2 Part Union
						1	Box & Rod

DATE \_\_\_\_\_

TOWN OF LEXINGTON — BOARD OF PUBLIC WORKS

WATER DIVISION

Sketch of Service Here

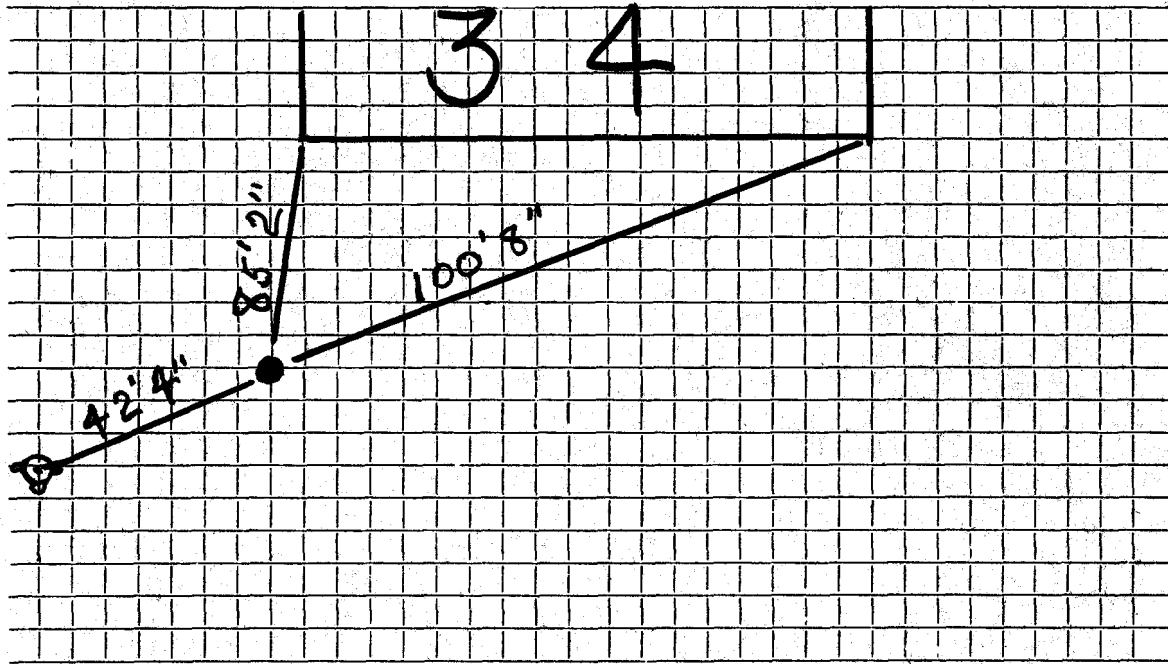

Connection made in ..... Street. Work completed .....

Remarks: .....  
.....  
.....