

Name William E. Denham

Service No. #10 2301

Address 6 Raymond Street

#5558

Location

Kind of Pipe

Size

Size of Main

~~Repair—Renewal—New Service~~

Location

Date
1937

Material

Amount

Total

Date

Amount

March 10,
Long St.

28 hrs @ 55¢

15 40

2 " @ 60¢

1 20

16 60

Overhead

1 66

40' 3/4" Cop.Tub. @ 22¢

8 80

1 3/4" S. & W.

3 00

2 hrs. Trucking @ 75¢

1 50

31 56

Trench repairs

3 33

34 89

March 8, 1937

Deposited

Raymond St.

70 00

35 11

34 89

Labor

DATE March 8-37

TOWN OF LEXINGTON—BOARD OF PUBLIC WORKS

WATER DIVISION

The undersigned applies for a supply of water at No. 6 Raymond St. and hereby agrees to comply with the rules and regulations as now, or at any future time, established by the Board of Selectmen.

Am't. of Estimate \$ 70⁰⁰


Owner William E. Dunham

Am't. Paid \$ _____

Address 6 Raymond St

Builder _____

Sketch of Service Here

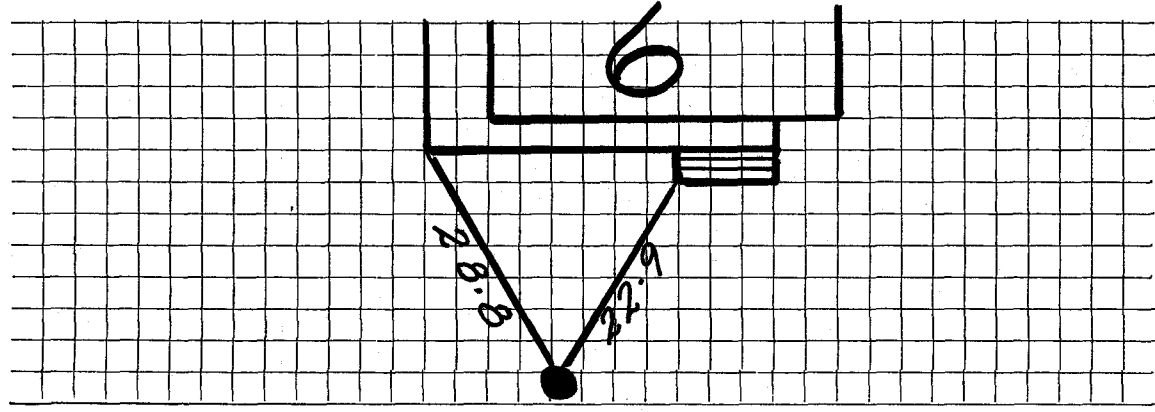

Connection made in _____ Street.

Work completed _____ 19

Remarks: