

**WATER SERVICE RECORD**

Name

Service No.

Address **8 Raymond Street**

Location

Repair ~~General New Service~~ **W.O. #1602**


Date	Material	Amount	Total	Date	Amount
7-12-40					
	34' 3/4" Copper				
	1 3/4" C. X 1/2" l. Stop + Waste				
	1 3/4" C. X 1. UNION				
					<b>OUTSIDE</b>
				3/12/81	Labor
				4/7/81	"
					3' 3/4" Copper tubing
					1 3/4" Curb
					1 3/4" 3 Part Union
					1 Box & Rod
					1 Ton Cold Patch
					Patch Sidewalk 6' x 10'
					Patch Street 9' x 10'
					5 hrs. Trucking
					2 hrs. Town Shovel
					1 hr. Compressor
					1 hr. Roller

DATE \_\_\_\_\_

TOWN OF LEXINGTON — BOARD OF PUBLIC WORKS

WATER DIVISION

Sketch of Service Here

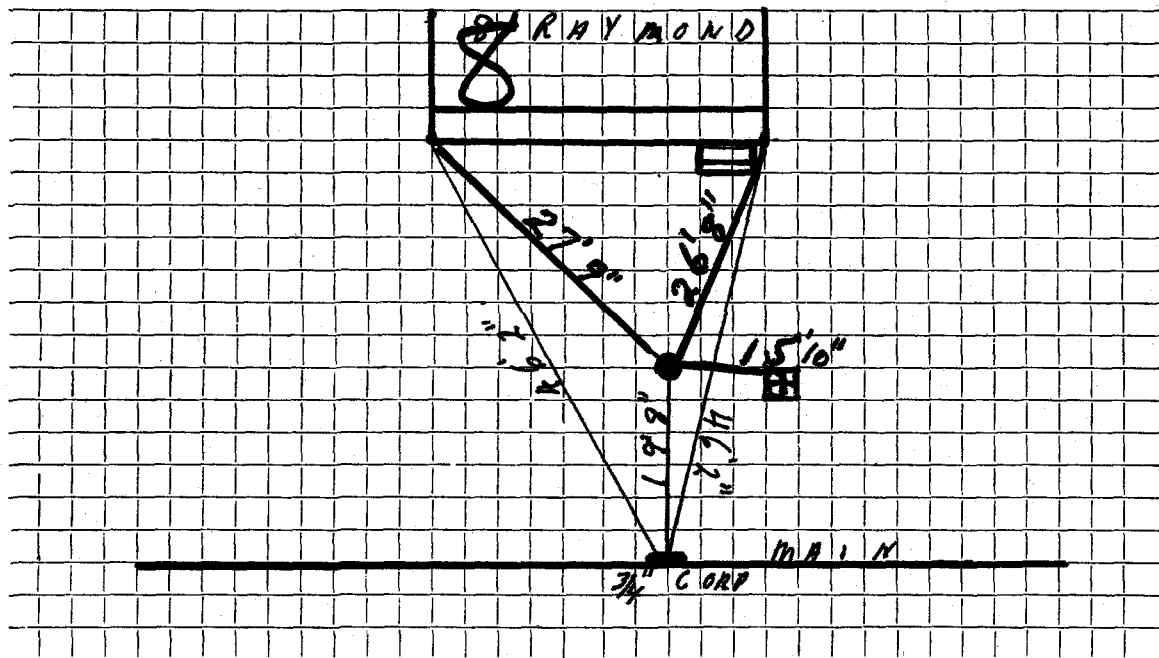

Connection made in ..... Street. Work completed .....

Remarks: 3/4 3 PART UNION 3' from CURB OUTSIDE