


DATE _____

TOWN OF LEXINGTON — BOARD OF PUBLIC WORKS

WATER DIVISION

Sketch of Service Here

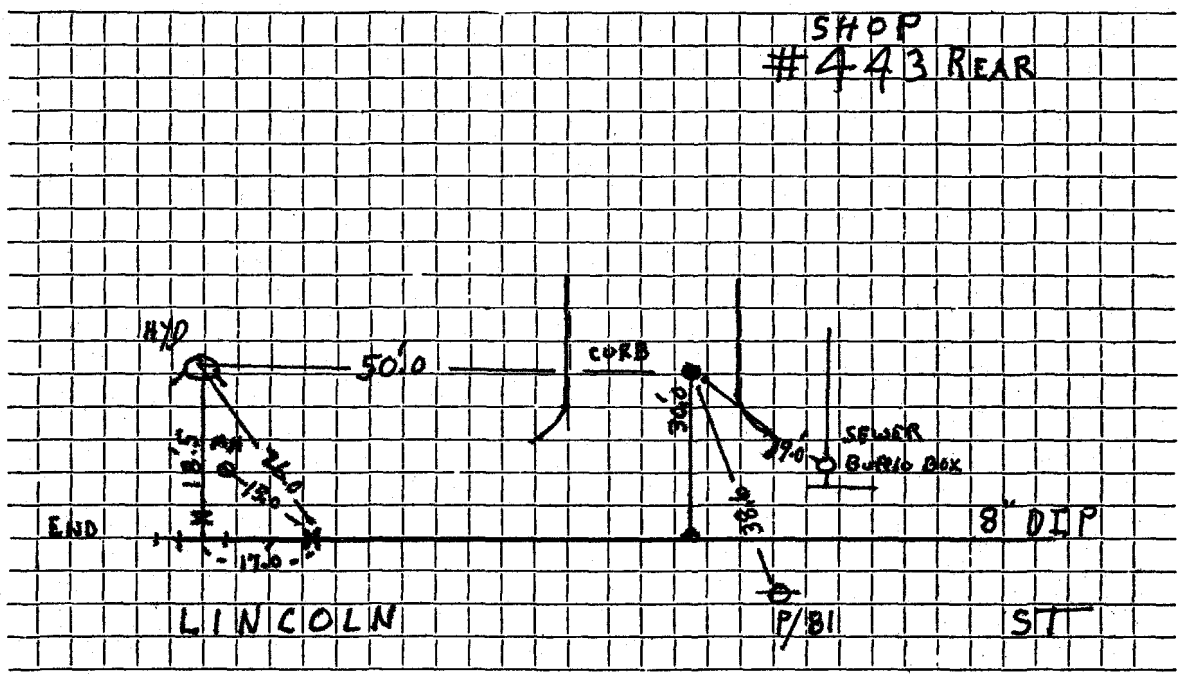

Connection made in Lincoln ST. Street. Work completed 2001

Remarks:

.....

.....