

WATER SERVICE RECORD

Name Lot 31

Service No.

Address 11 Red Coat Lane

Location

~~Repair - Renewal~~ - New Service SERVICE IN TO CURB


Date	Material	Amount	Total	Date	Amount
5-2-55	42' 3/4" Copper 1 3/4" C. X 1/2" I.W.H. Stop + Waste				
					<u>NON CHARGE</u>
				7/8/54	Labor 4.27
				25' - 3/4" Copper tubing @.35	8.75
				1 - 3/4" C. corp cock	4.33
				1 - 3/4" C x 3/4" C. Curb-cock	4.67
				1 box and rod	3.90
				1 hr. trucking	.75
					<u>26.67</u>

DATE _____

TOWN OF LEXINGTON — BOARD OF PUBLIC WORKS

WATER DIVISION

Sketch of Service Here

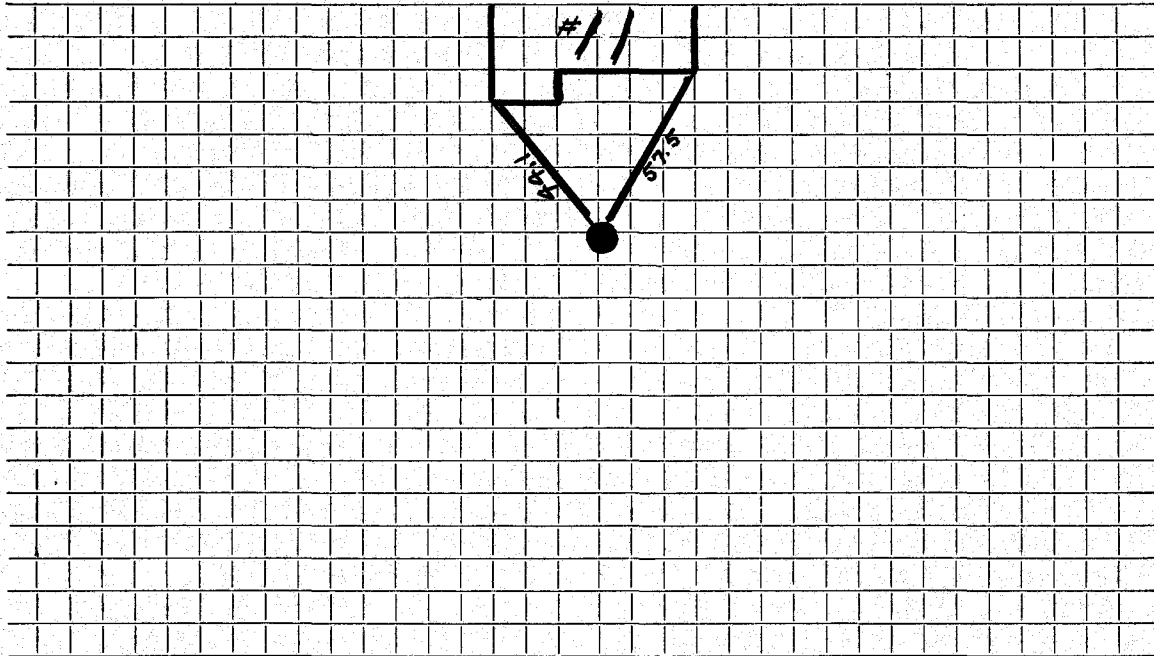

Connection made in Street. Work completed

Remarks:
.....
.....