

WATER SERVICE RECORD

Name Lot 32

Service No.

Address 15 Red Coat Lane

Location

~~Repair~~ ~~Renew~~ - New Service SERVICE IN TO CURB


Date	Material	Amount	Total	Date	Amount
10-1-54	32' 3/4" Copper 1 3/4" C. X 1/2" I.W.H. Stop + Waste				
					<u>NON CHARGE</u>
				7/8/54	Labor 4 27
				25' - 3/4" Copper tubing @ .35	8 75
				1 - 3/4" C. corp-cock	4 33
				1 - 3/4" C x 3/4" C. curb-cock	4 67
				1 box and rod	3 90
				1 hr. trucking	75
					26 67

DATE _____

TOWN OF LEXINGTON — BOARD OF PUBLIC WORKS

WATER DIVISION

Sketch of Service Here

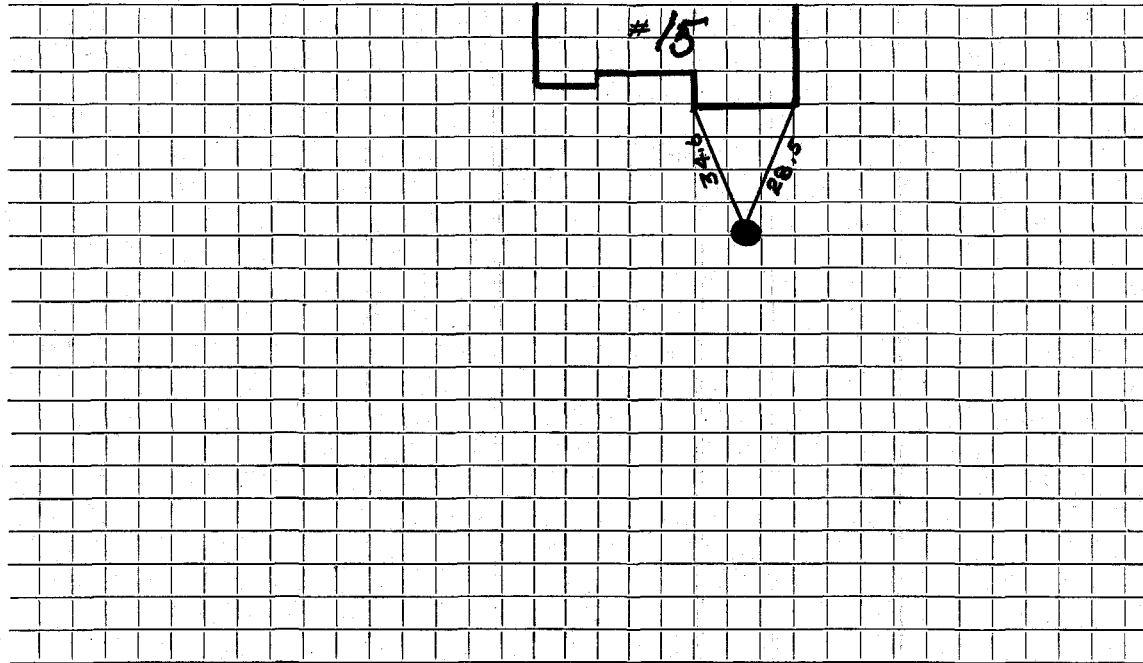

Connection made in Street. Work completed

Remarks:

.....

.....