

WATER SERVICE RECORD

Name Lot 56

Service No.

Address 16 Redcoat Lane

Location

~~Repair Removal~~ New Service SERVICE IN TO CURB


Date	Material	Amount	Total	Date		Amount
3-26-57						
50' ^{3/4"} Copper						
1 ^{3/4"} C. X ^{1/2"} I.W.H. STop + Waste						
					NON CHARGE	
				7/8/54	Labor	4 28
				25' - 3/4" Copper tubing @ .35		8 75
				1 - 3/4" C. corp-cock		4 33
				1 - 3/4" C x 3/4" C. curb-cock		4 67
				1 box and rod		3 90
				1 hr. trucking		75
						26 68

DATE _____

TOWN OF LEXINGTON - BOARD OF PUBLIC WORKS
WATER DIVISION

Sketch of Service Here

SERVICE FOR

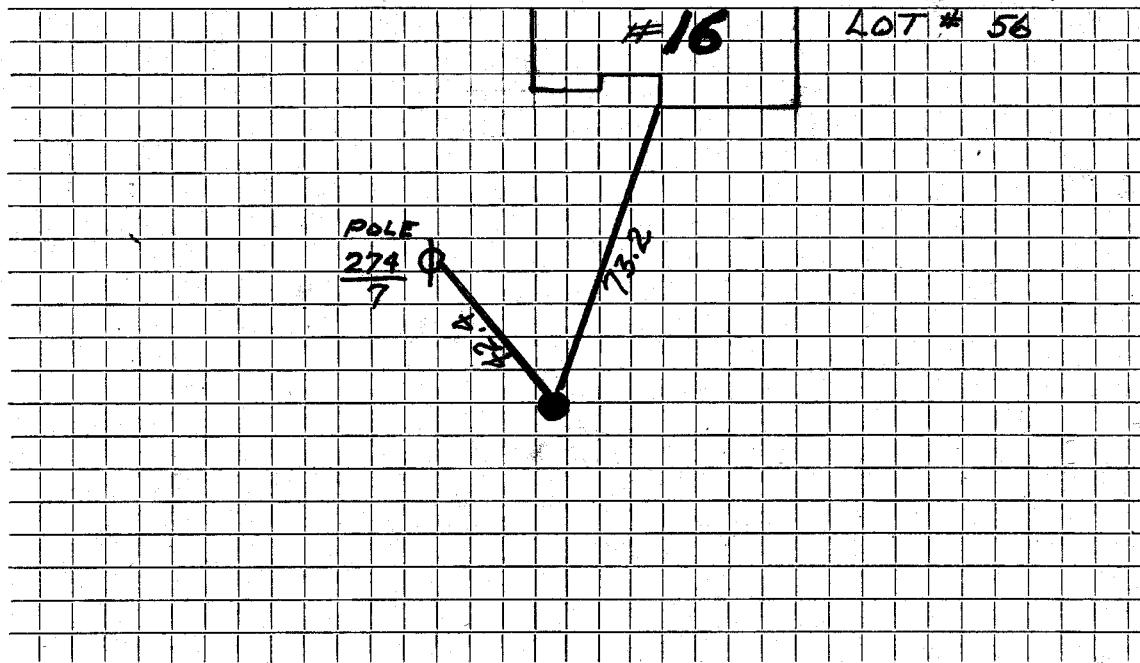

Connection made in Street. Work completed

Remarks: