

WATER SERVICE RECORD

Name Lot 53 E. S. Johnston

Service No. 294 (1957)

Address 18 Red Coat Lane

Location

~~Repair - Renewal - New Service~~

SERVICE IN TO CURB

Comm. 6-2-58

Date	Material	Amount	Total	Date	Amount
1/3/58	Labor	2 04		12-31-57	Deposit 35 20
	10% overhead	20	2 24	6-2-58	Balance 6 70
	55' - 3/4" Copper tubing @ .37		20 35		<u>NON CHARGE</u> #28 30
	1 - 3/4" C x 1/2 I.W.H. Stop & Waste		4 96	7/8/54	Labor 4 27
	1 hr. Trucking		75	25' - 3/4" Copper tubing @ .35	8 75
			28 30	1 - 3/4" C. corp-cock	4 33
				1 - 3/4" C x 3/4" C. curb-cock	4 67
				1 box and rod	3 90
				1 hr. trucking	75
					26 67
				1/3/58	1 - 1/2 Straight tailpiece 50
					1 - 1/2 Offset tailpiece 50
					27 67


DATE _____

TOWN OF LEXINGTON — BOARD OF PUBLIC WORKS

WATER DIVISION

Sketch of Service Here

SERVICE FOR
LOT # 53

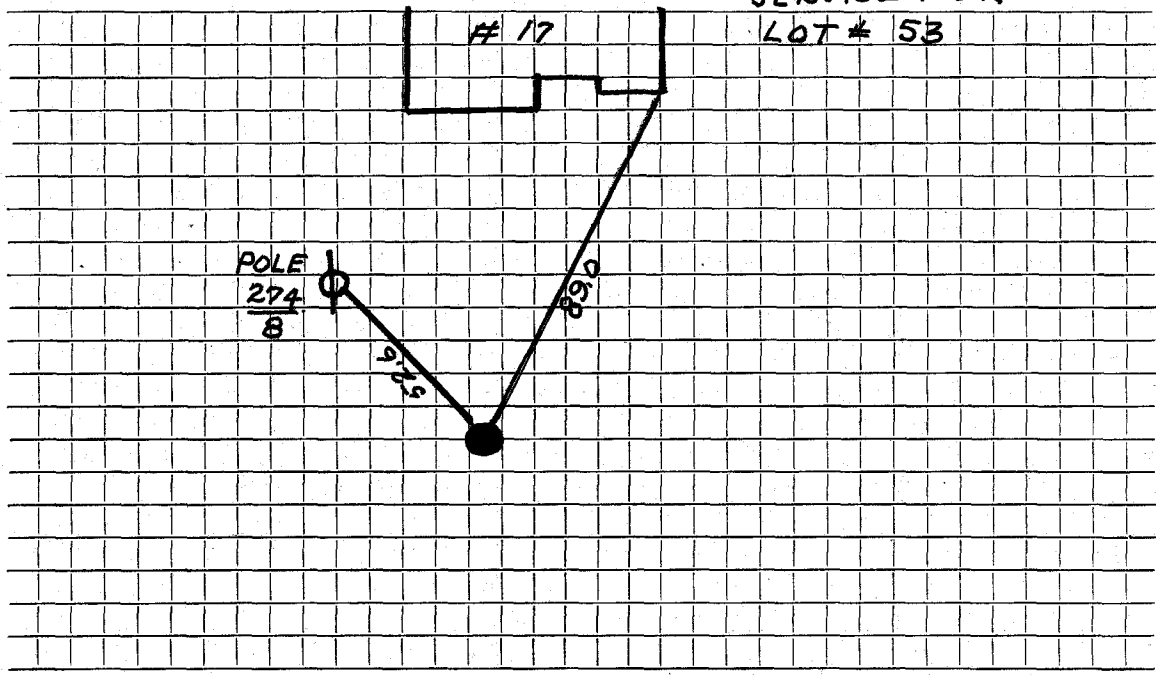

Connection made in Street. Work completed

Remarks:
.....
.....