

WATER SERVICE RECORD

Name Lot 34

Service No.

Address 19 Red Goat Lane

Location

~~Repair~~ ~~Remark~~ - New Service SERVICE IN TO CURB


Date	Material	Amount	Total	Date	Amount
10-16-54	60' 3/4" Copper				
	1 3/4" C. X 1/2" I.W.H. Stop + Waste				
					<u>NON CHARGE</u>
				7/7/54	Labor 3 56
					18' - 3/4" Copper tubing @ .35 6 30
					1 - 3/4" C. corp-cock 4 33
					1 - 3/4" C x 3/4" C. curb-cock 4 67
					1 box and rod 3 90
					1 hr. trucking 75
					<u>23 51</u>

DATE _____

TOWN OF LEXINGTON — BOARD OF PUBLIC WORKS

WATER DIVISION

Sketch of Service Here

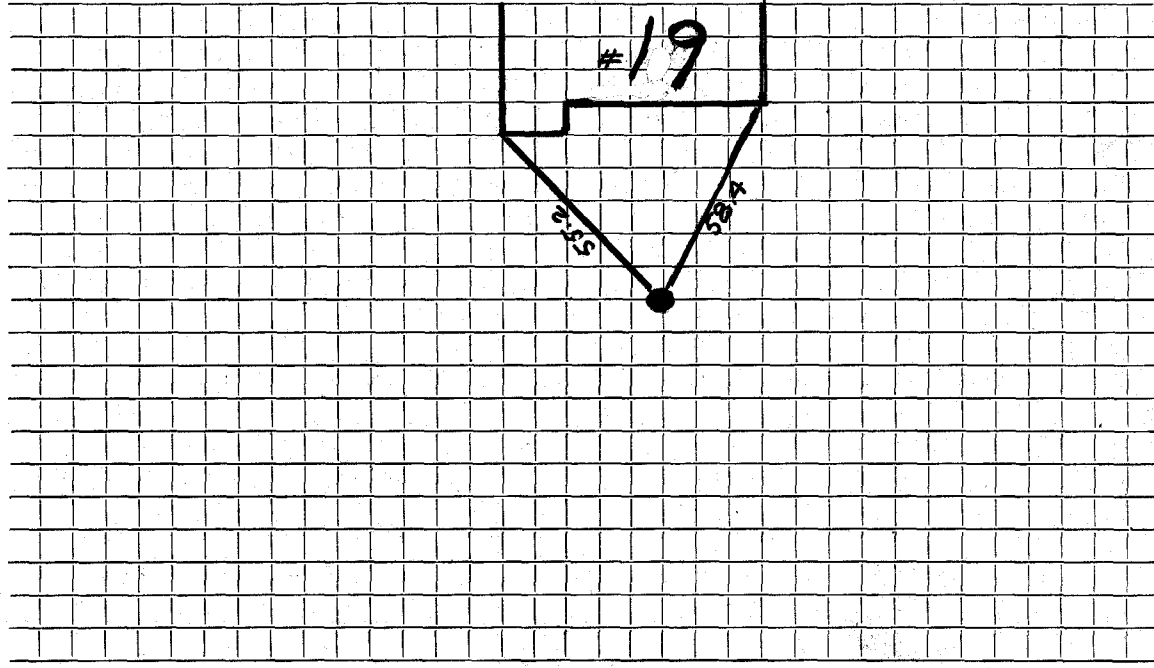

Connection made in Street. Work completed

Remarks:
.....
.....