

WATER SERVICE RECORD

2612

Name Universal-Builder's, Inc.

Service No. 373

Address 3 Red Coat Lane

Location Lexington

Con 11-30-53

~~REPAIR~~ New Service

TRENCH DUG BY OWNER

Date	Material	Amount	Total	Date	Amount
11/19/53	Labor	1 75		11-16-53	35 00
	10% overhead	18	1 93	11-30-53	6 55
	60'-3/4" Copper tubing @.3629	3629	21 77		28 45
	1-3/4" C x 1/2" I.W.H. STOP & WASTE	4 00	75		
	1 Hr. Trucking		28 45	11/19/53	3 30
				18'-3/4" Copper Tubing @.3629	6 53
				1-3/4" C. Corp-cock	4 33
				1-3/4" C x 3/4" C. Curb-cock	4 67
				1-Box & Rod	3 90
				1-1/2 straight tail piece	50
				1-1/2 offset tail piece	50
				1 Hr. Trucking	75
					24 48


Deposited
Refunded
NON CHARGE

DATE _____

TOWN OF LEXINGTON — BOARD OF PUBLIC WORKS

WATER DIVISION

Sketch of Service Here

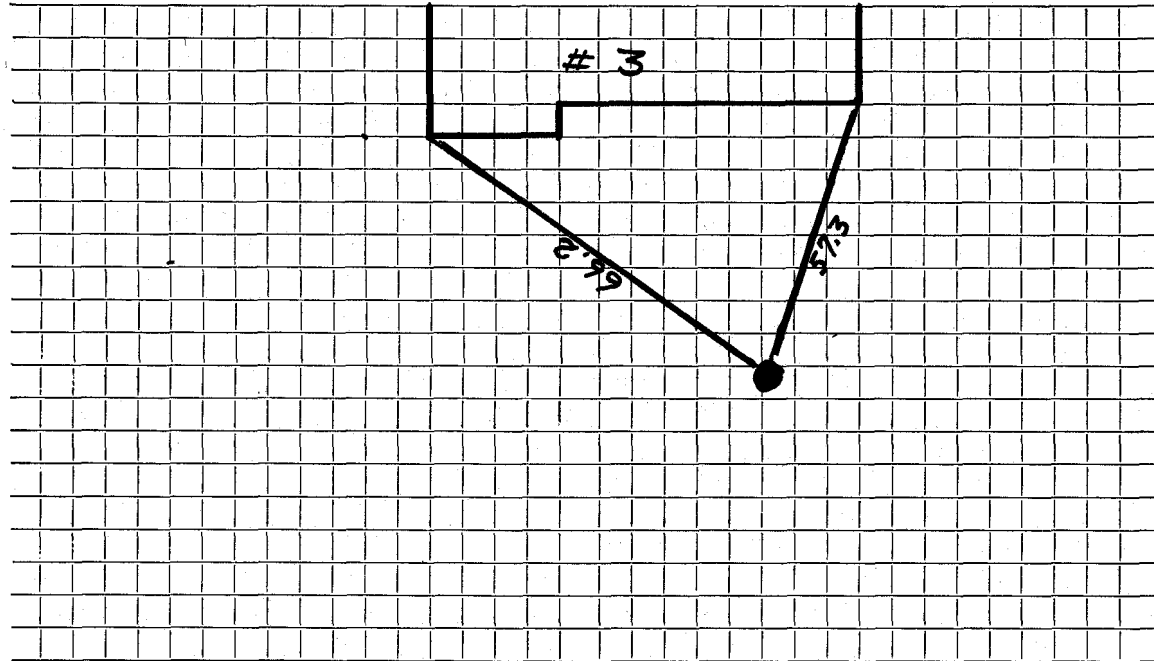

Connection made in Street. Work completed

Remarks:
.....
.....