

WATER SERVICE RECORD

Name William Schlaich

Service No. 199
(1961)

Address 4 Red Coat Lane

Location

~~Repaired~~ New Service

WO #6990

Comm 5-28-62


Date	Material	Amount	Total	Date	Amount	
1-5-62	Labor	6.00		12-7-62	Deposit	50.00
	10% O.H.	.60	6.60	5-28-62	Refund	1.23
	Owners Copper					48.77
	1 3/4" C x 1/2 IWH Stop & Waste		6.17			
	2 Hrs. Trucking @ 3.00		6.00			
	4 Hrs. Compressor @ 3.00		12.00	1/5/62	Labor	64.29
	18 X 3 Patch		18.00		23' 3/4" Copper Tubing @.45	9.66
			48.77		1 3/4" C Corp Cock	4.91
					1 3/4" Curb Cock	6.28
					1 Bow & Rod	4.90
					1 1/2 Straight Tailpiece	50
					1 1/2 Offset Tailpiece	50
						91.04

DATE _____

TOWN OF LEXINGTON — BOARD OF PUBLIC WORKS

WATER DIVISION

Sketch of Service Here

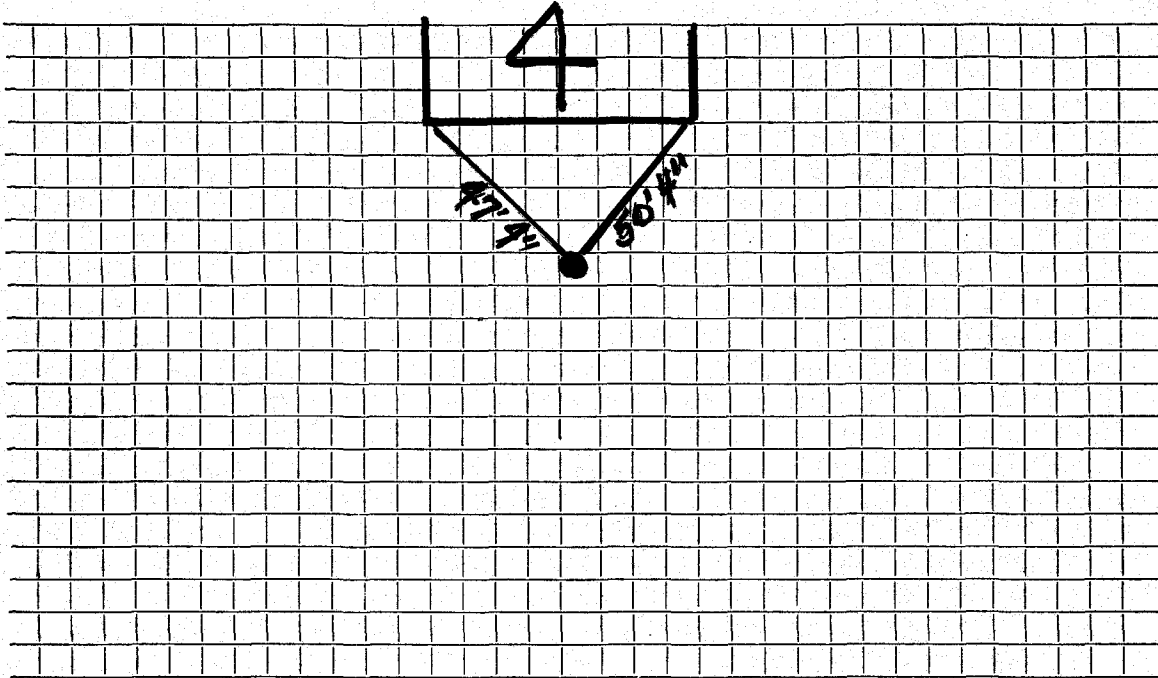

Connection made in Street. Work completed

Remarks: Original Service 5-18-54

.....
.....