


DATE 2017

TOWN OF LEXINGTON — BOARD OF PUBLIC WORKS

WATER DIVISION

Sketch of Service Here

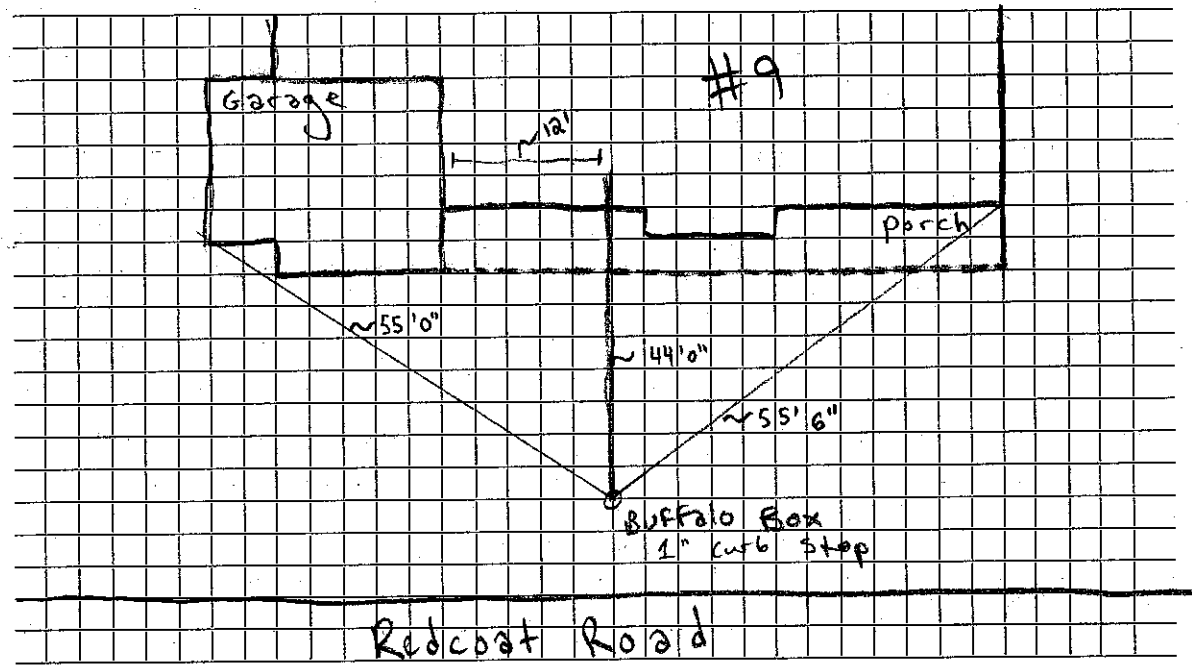

Connection made in Redcoat Road Street. Work completed

Remarks:

.....