




DATE 4/2014

TOWN OF LEXINGTON — BOARD OF PUBLIC WORKS

WATER DIVISION

Sketch of Service Here

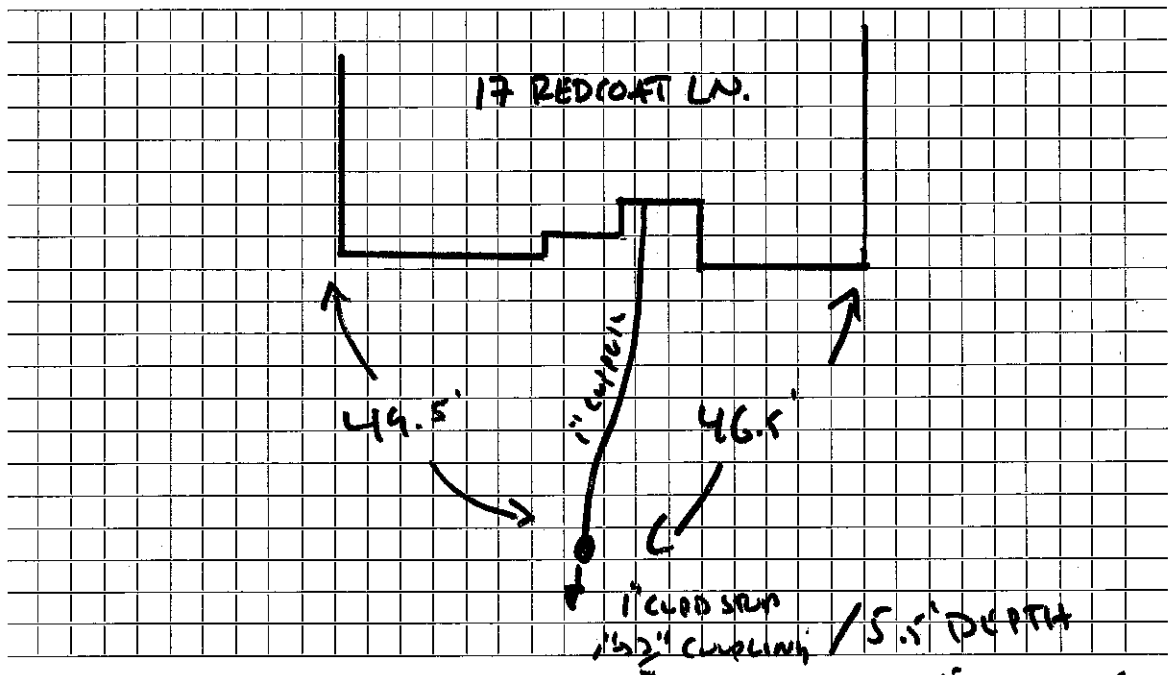

Connection made in REDCOAT Street.

Work completed EYCON CONSTRUCTION

Remarks: