

WATER SERVICE RECORD

Name **Frank L. Grazulis**

Service No. **123**

Address **108 Reed Street**

Location **Lexington**

~~Repair~~ **New Service**

*Com 9-22-52*


Date	Material	Amount	Total	Date	Amount
7/24/52	Labor	1 63		6-27-52	Deposited 25 00
	10% overhead	16	1 79	9-22-52	Refunded (11 38)
	15' - 3/4" copper tubing@.3439	5 16			<u>NON CHARGE</u> 13 42
	1 -3/4" C x 1/2 I.W.H. stop& waste	4 00		7/24/52	Labor 4 41
	1 -3/4" C x 3/4" C. union 3 pts.	1 72			6' - 3/4" copper tubing@.3439 2 06
	1 hr. trucking		75		1 -3/4" C. corp-cock 4 33
			13 42		1 -3/4" C x 3/4" C. curb-cock 4 67
					1 box and rod 3 90
	TRENCH DUG BY OWNER				1 1/2 offset tail piece 50
	PIPE SUPPLIED & LAID BY OWNER				1-1/2 straight tail piece 50
					2 hrs. Littlefield shovel 14 00
					1 hr. trucking 75
					<u>35 12</u>

DATE \_\_\_\_\_

TOWN OF LEXINGTON — BOARD OF PUBLIC WORKS

**WATER DIVISION**

Sketch of Service Here

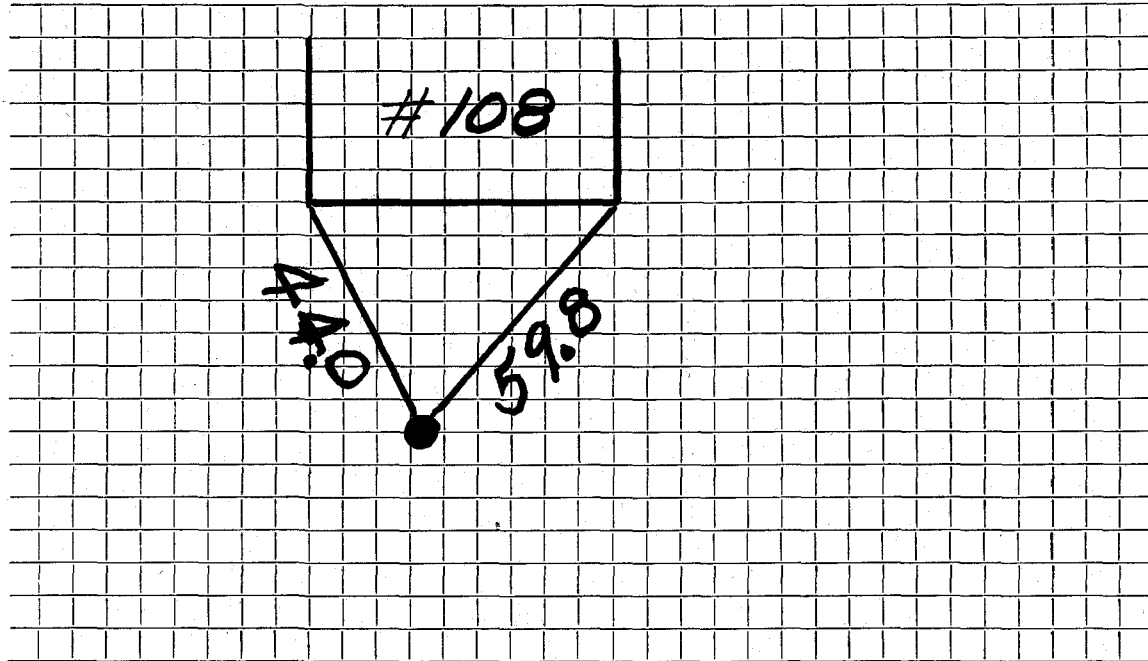

Connection made in ..... Street.                      Work completed .....

Remarks: .....

.....

.....