

WATER SERVICE RECORD

#5429

Name Barton A. Waldo

Service No. 37

Address 109 Reed Street

Location

~~Renewal~~ ~~RENEWAL~~

Com. 3-22-54

Date	Material	Amount	Total	Date	Amount
3/9/54	Labor	11 17		3-4-54	Deposited 75 00
	10% overhead	1 12	12 29	10-3-55	Plated 1 52
	110' - 3/4" copper tubing@.3629		39 92		<u>NON CHARGE</u>
	1 -3/4"C x 1/2" I.W.H.stop &waste		4 00	3/9/54	Labor 31 00
	1 -3/4"C x 3/4"C. union		1 72	95' - 3/4" copper tubing@.3629	34 48
	2 bags rockwool @ 1.42		2 84	20' - 3/4" copper tubing@ "	7 26
	2 hrs.Littlefield shovel@ 7.50		15 00	1 - 3/4"C. corp-cock	4 33
	1 hr. trucking		75	1 - 3/4"C x 3/4"C. curb-cock	4 67
			76 52	1 -3/4"C. union	1 72
				1 box and rod	3 90
				3 bags, rockwool @ 1.42	4 26
				5 2/3 hrs.Littlefield shovel@ 7.50	42 50
				patching	18 00
				1 hr. trucking	75
					152 87


bill sent 3-23-54

DATE _____

TOWN OF LEXINGTON — BOARD OF PUBLIC WORKS

WATER DIVISION

Sketch of Service Here

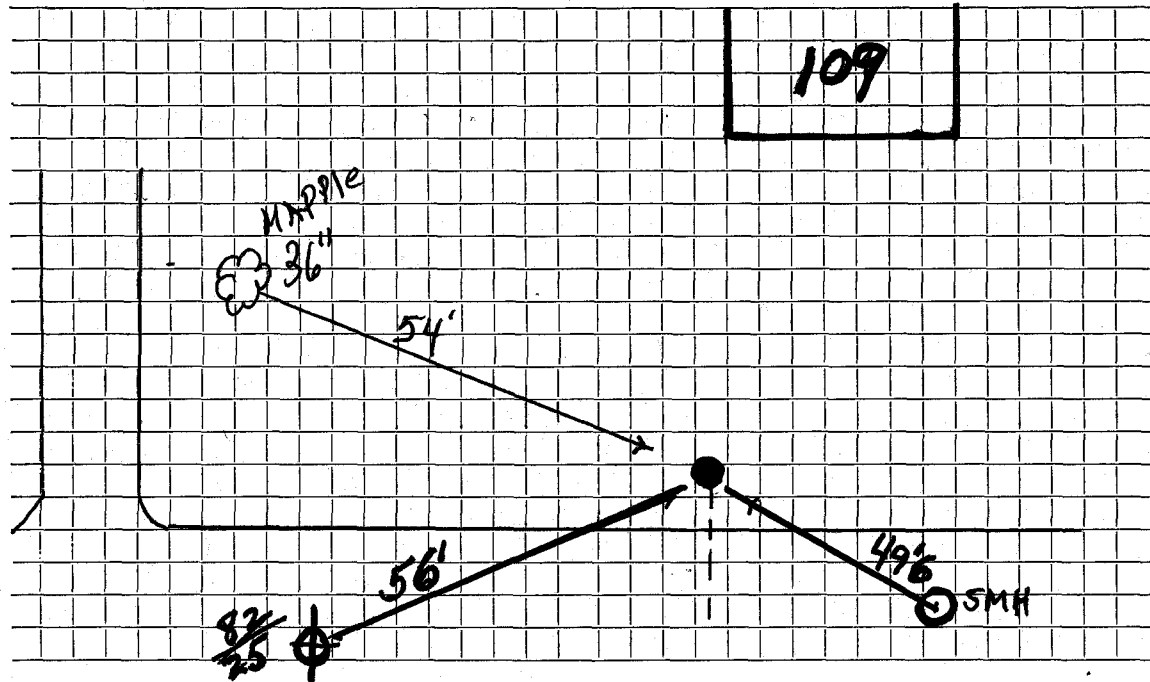

Connection made in Street. Work completed

Remarks:
.....
.....