


DATE _____

TOWN OF LEXINGTON — BOARD OF PUBLIC WORKS

WATER DIVISION

Sketch of Service Here

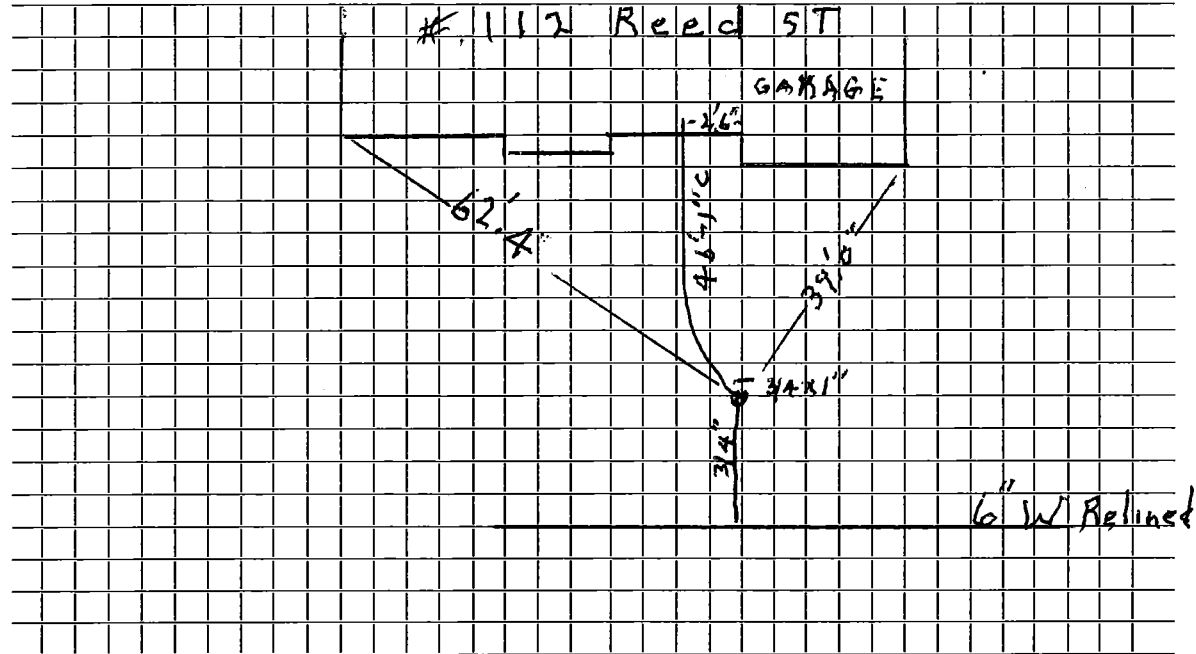

Connection made in Reed ST Street.

Work completed 7/15/11 J. McLaughlin

Remarks:

.....

.....