


DATE 12-30-94

TOWN OF LEXINGTON — BOARD OF PUBLIC WORKS

WATER DIVISION

Sketch of Service Here

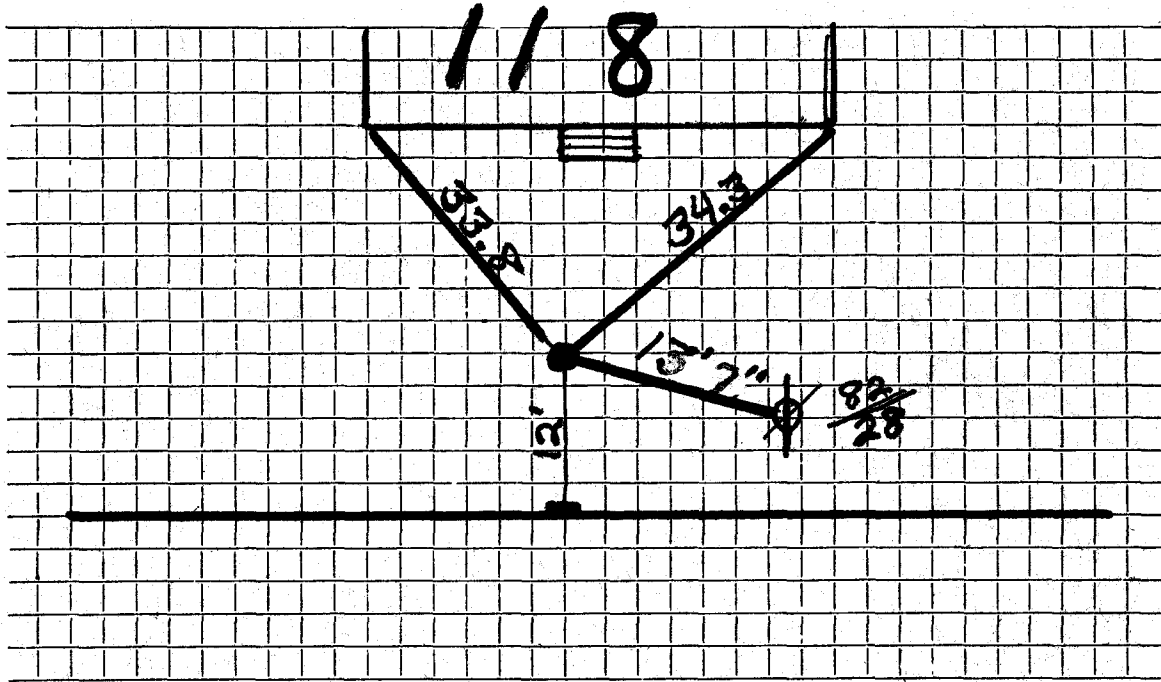

Connection made in Street. Work completed ... 12-27-94

Remarks:
.....
.....