

WATER SERVICE RECORD

3585

Name John Blandino

Service No. 16

Address 12-14 Reed Street

Location

~~Renewal~~ ~~NEW SERVICE~~ W.O. #8604


Comm 5-18-64

Date	Material	Amount	Total	Date	Amount	
3-27-64	Labor	74.27		3-24-64	Deposit	125.00
3-30-64	"	79.19	153.46	6-21-64	Paid	106.32
	10% O.H.	15.35	168.81			231.32
38'	3/4" Copper tubing @.42		15.96	1960	COPPER MAIN TO CURB	
1	3/4" c x 1/2 I.W.H. Stop & Waste		6.17			
3	bags Cement @1.55		4.65			
11	3/4 ton Bank Gravel @.85		9.98			
	1/2 ton sand @1.00		.50			
	1/2 ton 1 1/2" Stone @1.50		.75			
2	yds. Loam @3.00		6.00			
1	hr. Town Shovel @6.50		6.50			
4	hrs. Trucking @3.00		12.00			
			231.32			
					ANY QUESTIONS ON THIS BILL SEE GUY COLELLA	
					Bill sent 106.32	

TOWN OF LEXINGTON — BOARD OF PUBLIC WORKS

WATER DIVISION

Sketch of Service Here

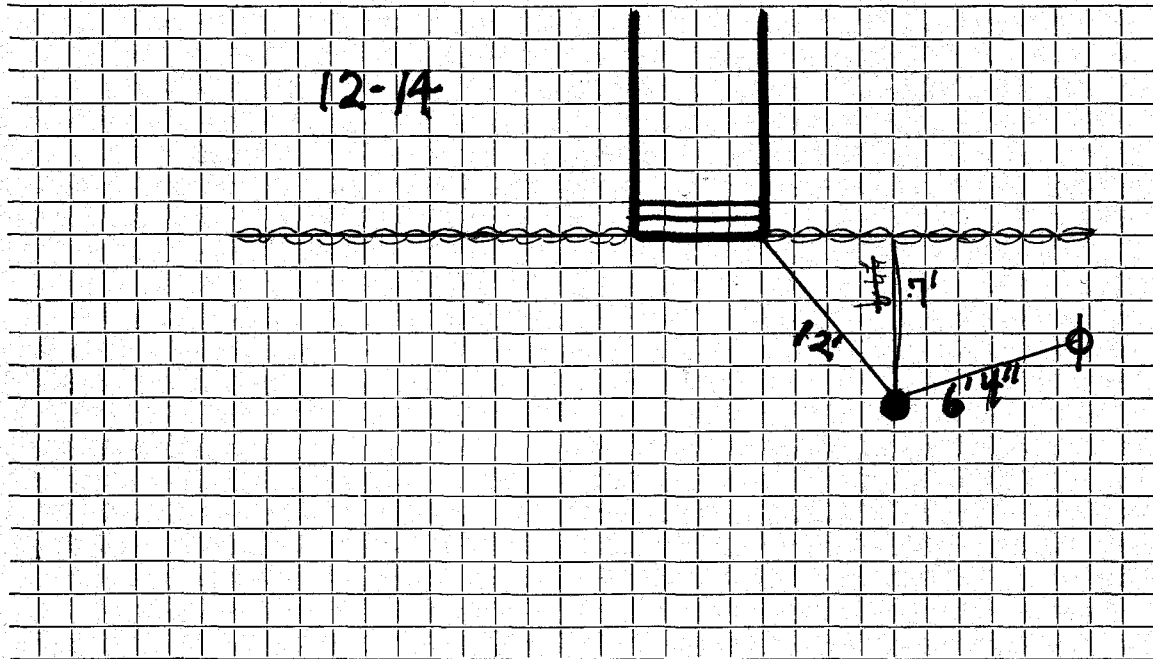

Connection made in Street. Work completed

Remarks:

.....
.....