

WATER SERVICE RECORD

Name Richard D. Hamilton

Service No. 158

Address 124 Reed Street

2499

Location

~~Repair~~ ~~Renewal~~ New Service

WO #7713

Comm 1-14-63

Date	Material	Amount	Total	Date	Amount
11-16-62	Labor	2.24		11-6-62	Deposit 50.00
	10% O.H.	.22	2.46	1-14-63	Refund 21.21
	48' 3/4" Copper tubing @.42		20.16		28.79
	1 3/4" x 1/2 I.W.H. Stop & Waste		6.17		NON CHARGE
5-17-63	Repair		28.79	11-16-62	Labor 2.13
	1 Box + Rod				7' 3/4" Copper tubing @.42 2.94
					1 3/4" C Corp Cock 4.91
					1 3/4" C Gurb Cock 6.28
					1 Box & Rod 4.90
					1 1/2 Straight tailpiece 50
					1 1/2 Offset tailpiece 50
					<u>22.16</u>


* Applied to SHC #784

DATE _____

TOWN OF LEXINGTON — BOARD OF PUBLIC WORKS

WATER DIVISION

Sketch of Service Here

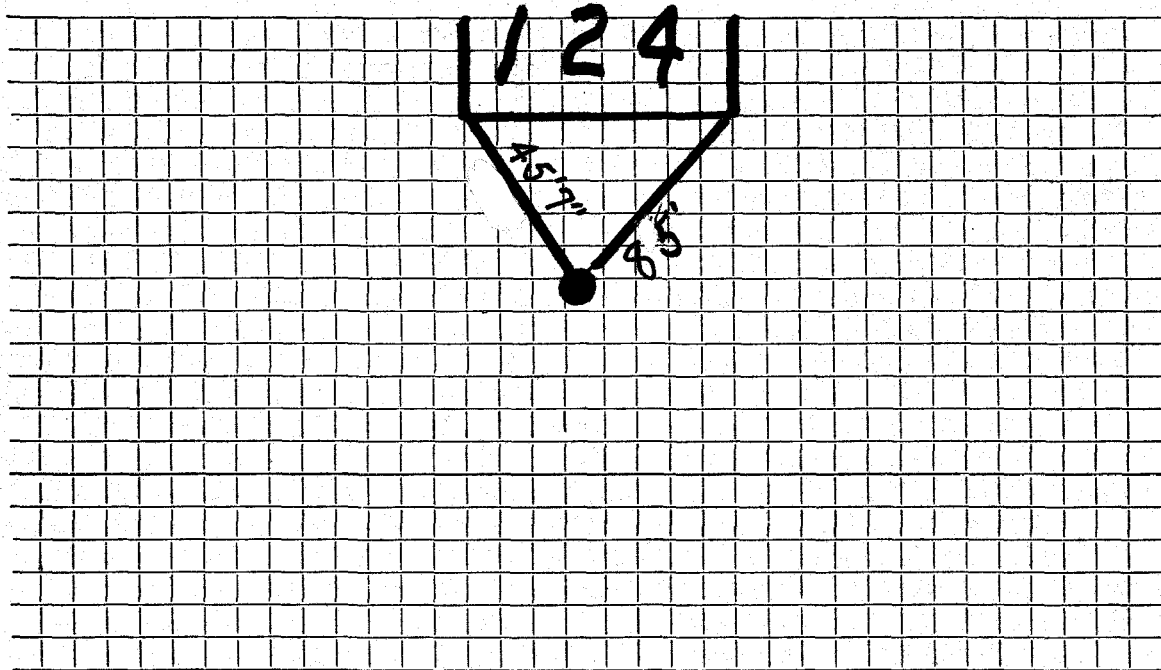

Connection made in Street. Work completed

Remarks:

.....

.....