

WATER SERVICE RECORD

5128

Name Mark Moore, Jr.

Service No. 23 & 70

Address 125 Reed Street

2 deposits

Location

~~Renewal~~ ~~Renewal~~ - New Service

Com. 6-13-55


Date	Material	Amount	Total	Date	Amount
4/14/55	Labor	7 57		2-24-55 Deposited	25 00
	10% overhead	76	8 33	3-17-55 "	50 00
	55' - 3/4" copper tubing@.3693		20 31	6-13-55 Refunded	(14 61)
	2 hrs. Littlefield shovel@7.50		15 00		<u>60 39</u>
	1 hr. trucking		75	4/14/55 Labor	7 58
	patching 16 x 3		16 00	23' - 3/4" copper tubing@.3693	8 49
			60 39	1 - 3/4" C. corp-cock	4 33
				1 - 3/4" C. curb-cock	4 67
				1 box and rod	3 90
				1 - 1/2 straight tail pc.	50
				1 - 1/2 offset tail pc.	50
				1 hr. Littlefield shovel	7 50
				1 hr. trucking	75
					<u>38 22</u>

DATE _____

TOWN OF LEXINGTON — BOARD OF PUBLIC WORKS

WATER DIVISION

Sketch of Service Here

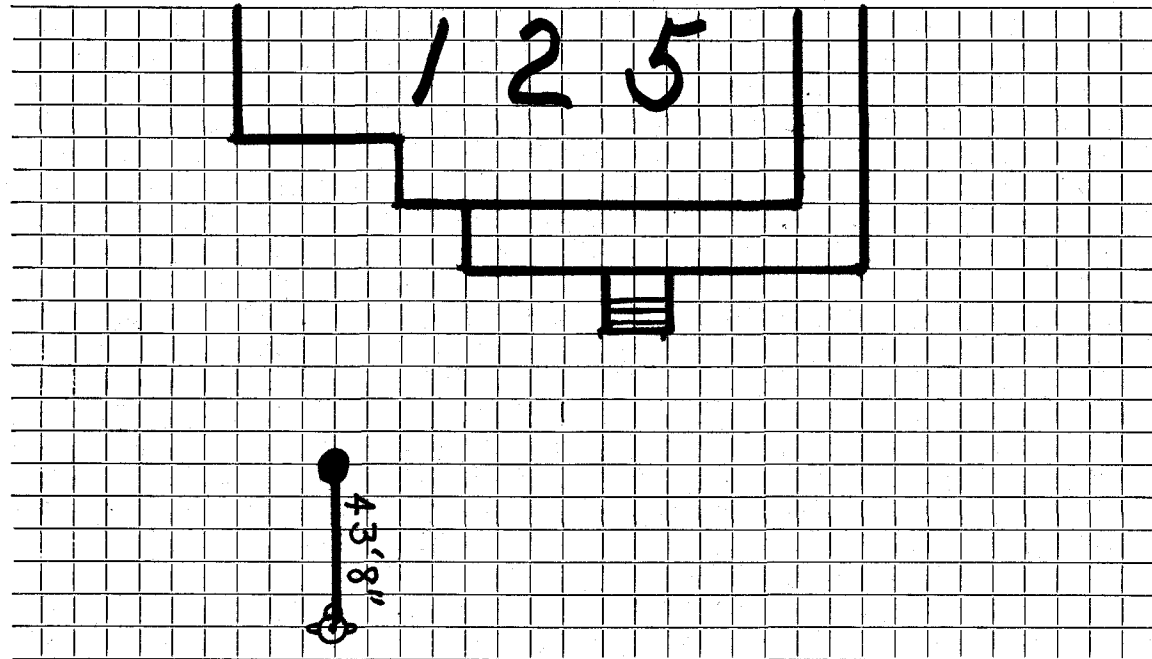

Connection made in Street. Work completed

Remarks:
.....
.....