

Name Fred Viano

Service No.

#4266

Address 13 Reed Street

Lexington, Mass.

Location 13 Reed Street

Kind of Pipe

Size

Size of Main

~~XXXXXXXXXX~~ New Service Com. June 7, 1948

Location

Date	Material	Amount	Total	Date	Amount
Apr. 22, '48	Labor	1 05	1 05	April 22, 48	20 00
	10% Overhead		11		
	34' - 3/4" Copper Tubing @ .255	8 67			Non-Charge
	1 - 3/4" C x 3/4" I Union		1 32	Apr. 22, '48	Labor 8 65
	Trucking 1 hr. @ .75		75		30' - 3/4" Copper Tubing @ .255 7 65
	Patching 9 x 3		9 00		1 - 3/4" C Corp-cock 3 00
			20 90		1 - 3/4" C x 3/4" C Curb-cock 3 68
	No additional bill				1 - Box & Rod 3 50
					Compressor 2 hrs. @ 1.75 3 50
					1 - 1/2" Offset Taul Piece 30
	Trench dug by owner				1 - 1/2" Straight Tail Piece 30
					Trucking 1 hr. @ .75 75
	Labor				31 33

TOWN OF LEXINGTON - BOARD OF PUBLIC WORKS

WATER DIVISION

The undersigned applies for a supply of water at No..... St. and hereby agrees to comply with the rules and regulations as now, or at any future time, established by the Board of Selectmen.

Am't of Estimate \$.....

Owner


Am't Paid \$.....

Address

Builder

.....

Sketch of Service Here

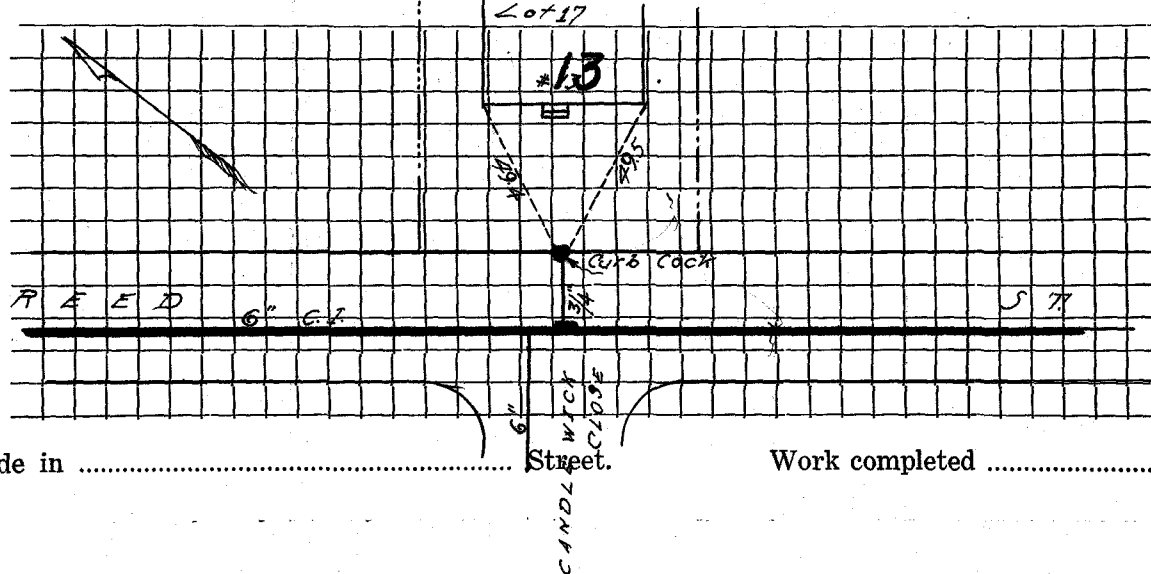

Connection made in

Street.

Work completed19

Remarks: