

WATER SERVICE RECORD

Name Will. H. Sullivan

Service No. 324

Address 133 Reed St.

Location Lexington

~~REPAIR WORK~~—New Service COM. 12-8-52


Date	Material	Amount	Total	Date	Amount
12/1/52	Labor	1 80		11-28-52 Deposited	20 00
	10% overhead	18	1 98	12-22-52 Paid	(5 09
	54' -3/4" copper tubing @ .34	18 34	18 36	NON CHARGE	25 09
	1 -3/4" C x 1/2 I.W.H. stop & waste	4 00	4 00	12/1/52 Labor	1 39
	1 hr. trucking		75	1 -1/2 offset tail pc.	50
			25 09	1 -1/2 straight tail pc.	50
	TRENCH DUG BY OWNER				2 39
				SERVICE WAS IN TO CURB	
				OLD PIT AT #135 REED ST.	
				28' 3/4" Copper	
				1 Shut off	
				1 Box + Rod	

DATE \_\_\_\_\_

TOWN OF LEXINGTON — BOARD OF PUBLIC WORKS

WATER DIVISION

Sketch of Service Here

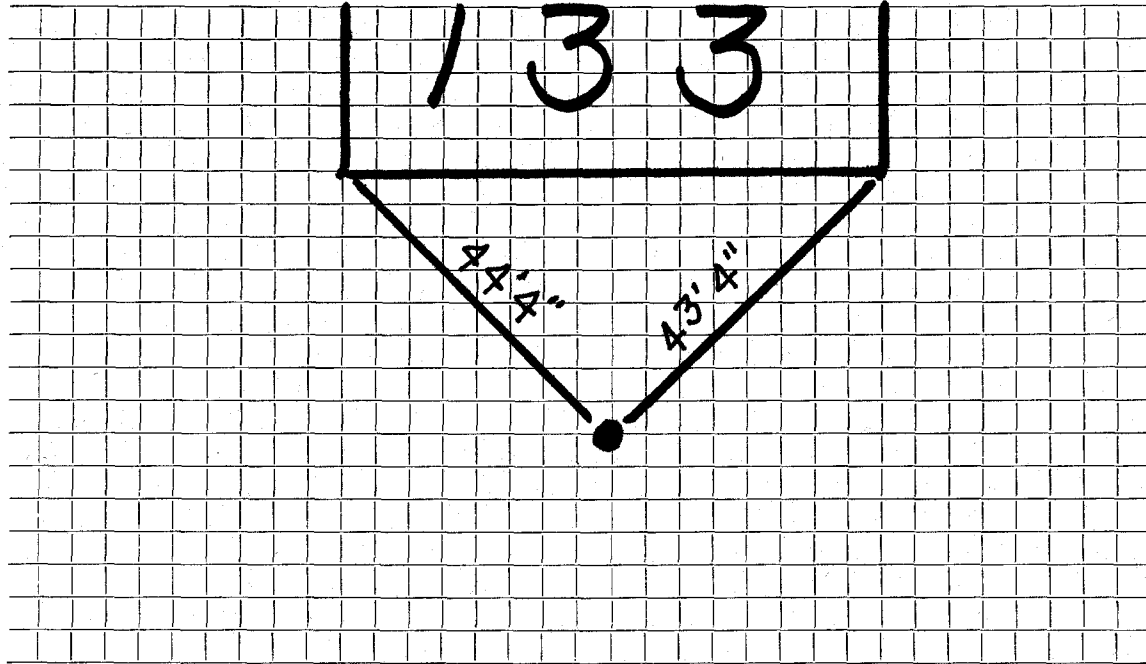

Connection made in ..... Street. Work completed .....

Remarks: .....  
.....  
.....