

WATER SERVICE RECORD

Name Osgood Bros.

Service No. 17

Address 137 Reed Street

Location

~~Repair/Repair~~ New Service

DeFelice #3003 W.O. #5618

AUG 29 1977


| Date | | Material | Amount | Total | Date | Amount |
|---------|-----|-------------------------|--------|---------|---------|-----------------|
| 7/19/77 | | labor | 51. 48 | | 7/8/77 | Deposit 175. 00 |
| | | 10%OH | 5. 15 | 56. 63 | 8/29/77 | Refund 18. 16 |
| | 28' | 3/4" copper @ .65 | | 18. 20 | | 156. 84 |
| | 1 | 3/4 corporation | | 10. 53 | | |
| | 1 | 3/4 curb | | 15. 07 | | |
| | 1 | box and rod | | 13. 41 | | |
| | 2 | tons cold patch @ 13.25 | | 26. 50 | | |
| | 2 | hrs. trucking @ 3.00 | | 6. 00 | | |
| | 1 | hr. loader @ 4.00 | | 4. 00 | | |
| | 1 | hr. shovel @ 6.50 | | 6. 50 | | |
| | | | | 156. 84 | | |
| 6/26/77 | 78' | 3/4" copper | | | | |

DATE _____

TOWN OF LEXINGTON — BOARD OF PUBLIC WORKS

WATER DIVISION

Sketch of Service Here

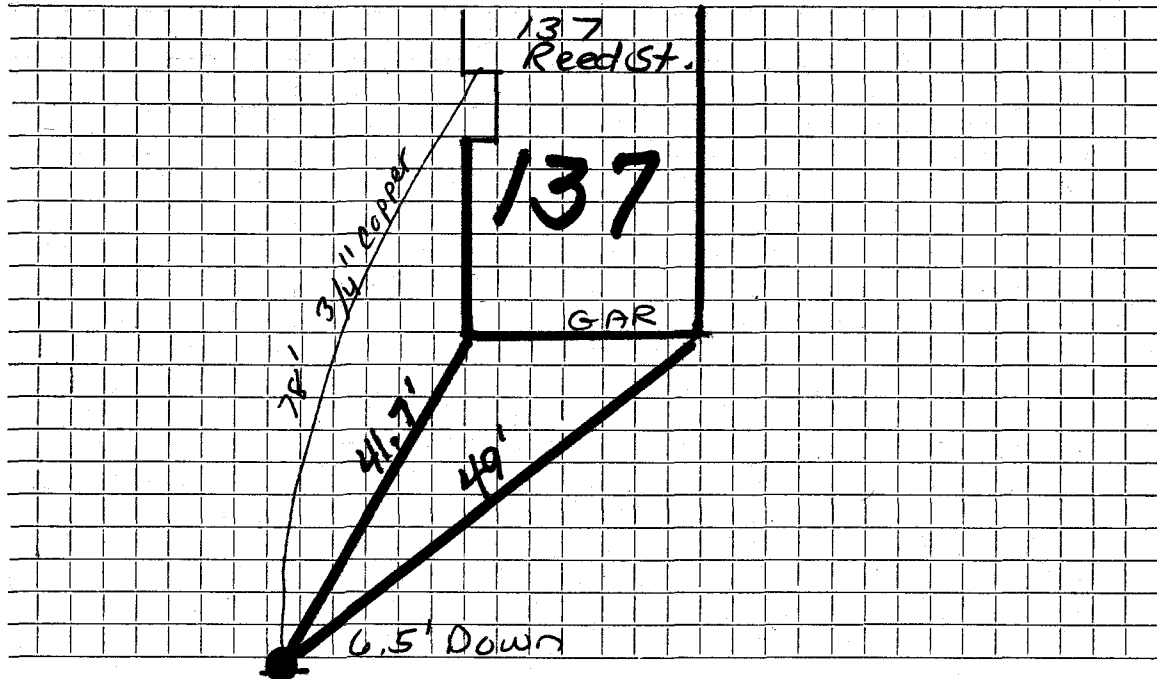

Connection made in Street. Work completed

Remarks:
.....
.....