

WATER SERVICE RECORD

Name

Service No.

Address

139 Reed Street

Location

Repair—Renewal—New Service


Date	Material	Amount	Total	Date	Amount
10-22-48	58' 3/4" Copper 1 3/4"C. X 1/2" l.w. H. Stop + Waste				
				NON CHARGE	
				4/21/58 Labor	4 28
				8' 1" Copper Tubing @ 52	4 16
				5' 3/4" Copper Tubing @ 37	1 85
				1 1" x 1" 2 Part Union	1 97
				1 1" Corp Cock	7 06
				1 Hour Trucking @ 75	75
					20 07
10-22-48	Original Service				
	31' 3/4" Copper				
	1 3/4"C. Corp Cock				
	1 3/4"C. X 3/4"C. Curb Cock				
	1 Box + Rod				

DATE _____

TOWN OF LEXINGTON — BOARD OF PUBLIC WORKS

WATER DIVISION

Sketch of Service Here

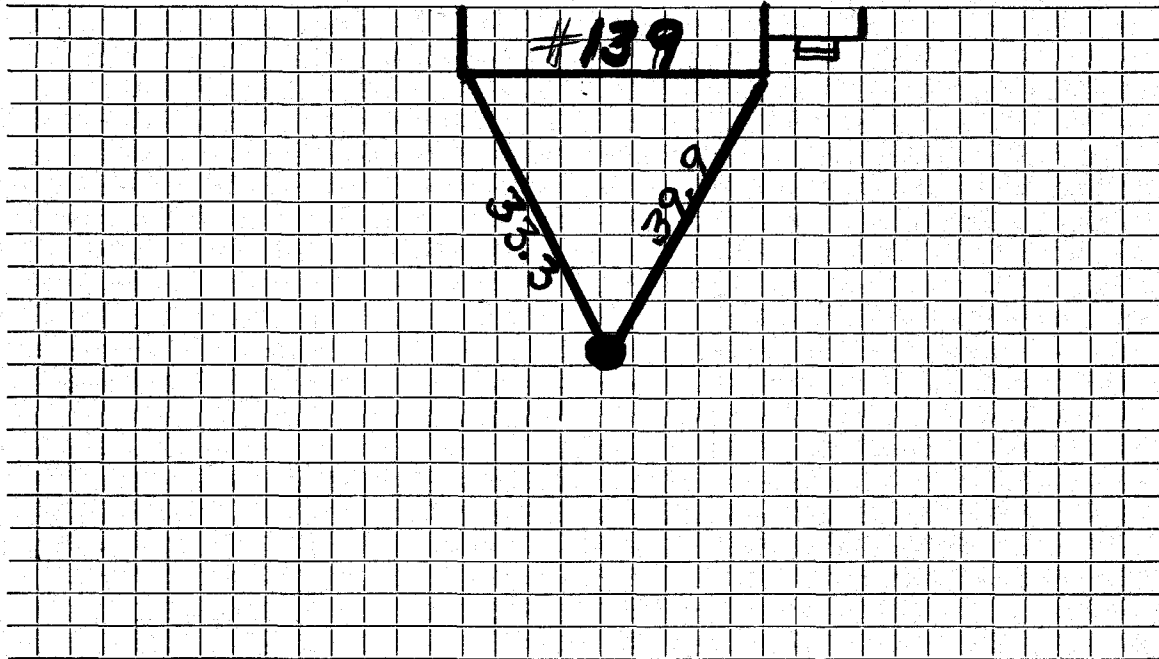

Connection made in Street. Work completed

Remarks:
.....
.....